

SHARKEY
A 54
10/16/78

MISSISSIPPI
 BOARD OF WATER COMMISSIONERS
 416 North State Street
 Jackson, Mississippi 39201
WATER WELL DRILLERS LOG

CODED

October 16, 1978 date well completed Dyer Well & Irr. firm name Sharkey county well located

| LANDOWNER: <u>Caselli + Caselli</u> | description of formations encountered | from | to |
|---|---------------------------------------|------------|------------|
| <u>Delta City, Miss.</u> (mailing address) | <u>Clay</u> | <u>0</u> | <u>13</u> |
| WELL LOCATION: sec. <u>22</u> T. <u>14</u> N. R. <u>6</u> E S <u>2</u> miles <u>SW</u> of <u>Delta City</u> (distance) (direction) (nearest town) | <u>Clay</u> | <u>13</u> | <u>23</u> |
| WELL PURPOSE: <u>Irrigation</u> (home, irrigation, municipal, industrial) | <u>Clay + Fine Sand</u> | <u>23</u> | <u>33</u> |
| WELL COMPLETION DATA: | <u>Fine Sand</u> | <u>33</u> | <u>43</u> |
| (1) diameter (inches) <u>16"</u> | <u>SAND + GRAVEL</u> | <u>43</u> | <u>53</u> |
| (2) total depth (feet) <u>113'</u> | <u>SAND + GRAVEL</u> | <u>53</u> | <u>63</u> |
| (3) static water level (feet) <u>18'</u> below top of ground. | <u>SAND + GRAVEL</u> | <u>63</u> | <u>73</u> |
| (4) casing <u>Steel</u> <u>73'</u> (material) (depth) | <u>SAND + GRAVEL</u> | <u>73</u> | <u>83</u> |
| <u>16"</u> if telescope see back. (size) | <u>SAND + GRAVEL</u> | <u>83</u> | <u>93</u> |
| (5) screen <u>40'</u> <u>73'</u> (length) (depth to top) | <u>SAND + GRAVEL</u> | <u>93</u> | <u>103</u> |
| <u>16"</u> <u>Steel</u> (size) (material) | <u>SAND + GRAVEL</u> | <u>103</u> | <u>113</u> |
| (6) pump <u>125</u> <u>2600</u> (HP) (yield gpm) | | | |
| <u>Diesel</u> (type power) | | | |
| (7) electric log <u>No</u> (yes or no) | | | |
| (organization running log) | | | |
| (8) how well bottom plugged <u>Plate</u> | | | |
| DRILLERS REMARKS: | | | |


CODED

RECEIVED
 NOV - 6 1978

MISS. BD. OF WATER COMM.

If well telescopes please sketch and show depths.

GROUND LEVEL

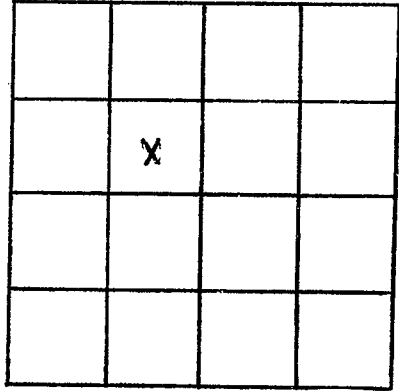

SECTION 22

Please indicate well location X.

ADDITIONAL INFORMATION

A series of horizontal lines for writing additional information.

If more than one screen, show locations of each on sketch.