

SHARKEY


CL-1486

A 57

3-25-80

3-25-

MISSISSIPPI BOARD OF WATER COMMISSIONERS
416 North State Street
Jackson, Mississippi 39201

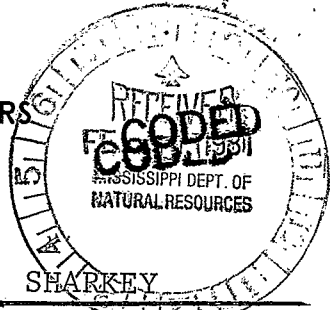

WATER WELL DRILLERS LOG

80 LAYNE-CENTRAL CO.

SHARKEY

date well completed

firm name

county well-located

LANDOWNER:

BOYKIN BROTHERS
TRIPLE B FARMS

DELTA CITY, MS 39061
(mailing address)

WELL LOCATION:

sec. 11 T 14 (N) R 6 E
S (W)

1 miles NE of Delta C.
(distance) (direction) (nearest town)

WELL PURPOSE: irrigation
(home, irrigation, municipal, industrial)

WELL COMPLETION DATA:

(1) diameter (inches) 32"
(2) total depth (feet) 116'
(3) static water level (feet) 19' below
top of ground.

(4) casing steel 66'
(material) (depth)
16" If telescope see back.
(size) 50' 66'

(5) screen 16" (length) (depth to top)
st. steel
(size) (material)
60 2800

(6) pump diesel
(HP) (yield gpm)
(type power)

(7) electric log no
(yes or no)

(organization running log)

(8) how well bottom plugged st. plate

description of formations encountered

from to

clay 0 20
coarse sand 20 40
c. sand & pea gravel 40 80
gravel 80 98
coarse sand 98 122

DRILLERS REMARKS:

