

MISSISSIPPI DEPARTMENT OF NATURAL RESOURCES

Bureau of Land and Water Resources

Southport Mall

P.O. Box 10631

Jackson, Mississippi 39209

WATER WELL DRILLERS LOG

CODED

SHARKEY

A58

E Log #107

3/10/81

March 10 1981

date well completed

81 E.M. "Bud" Cresswell

firm name

Sharkey county well located

LANDOWNER:

PAT Patton

description of formations encountered

from

to

Nitta Yuma, MS.
(mailing address)

Clay	0	20
Hard-graup	20	180
Hard	180	320
Hard-shell	320	620
Hard	620	800

WELL LOCATION:

sec 30 T 14 N R 6 E

at Nitta Yuma
(distance) miles (direction) of (nearest town)

WELL PURPOSE: farm
(home, irrigation, municipal, industrial)

WELL COMPLETION DATA:

(1) diameter (inches) 4
(2) total depth (feet) 800
(3) static water level (feet) 10 below top of ground.

(4) casing Steel 760
(material) (depth)
4 if telescope see back.
(size)


(5) screen 40 760
(length) (depth to top)
2 Stainless
(size) (material)

(6) pump 2 50
(HP) (yield gpm)
(type power) Yes

(7) electric log Yes
(yes or no)
Mr. State Geophysics
(organization running log)

(8) how well bottom plugged
back wash

DRILLERS REMARKS:

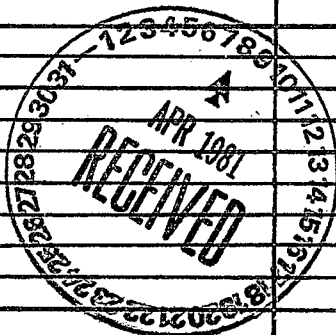


DEPT. OF NATURAL RESOURCES
BUREAU OF LAND & WATER RESOURCES

APR - 8 1981

RECEIVED

If well telescopes please sketch and show depths.

GROUND LEVEL

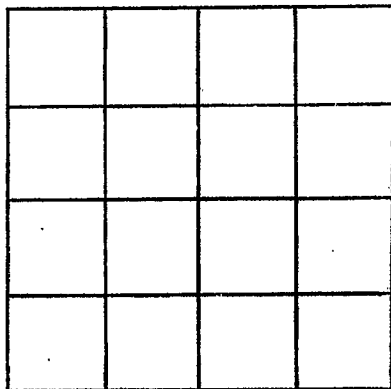

SECTION _____

Please indicate well location X.

ADDITIONAL INFORMATION

If more than one screen, show locations of each on sketch.