

MISSISSIPPI DEPARTMENT OF NATURAL RESOURCES

Bureau of Land and Water Resources

Southport Mall

P.O. Box 10631

Jackson, Mississippi 39209

WATER WELL DRILLERS LOG

COPIED

SHARKEY

A62

7-25-80

7/25/80
date well completed

Larry's well & Pump
firm name

Sharkey
county well located

LANDOWNER: W.D. Kent

description of formations encountered

from to

This location about 10 1/2 mi S of Hollandale

Hollandale, MS.
(mailing address)

WELL LOCATION:

sec. 32T-14N R-E
S-6
6 miles South of Hollandale
(distance) (direction) (nearest town)

WELL PURPOSE: Home
(home, irrigation, municipal, industrial)

WELL COMPLETION DATA:

(1) diameter (inches) 4" x 2"

(2) total depth (feet) 650'

(3) static water level (feet) 20 below top of ground.

(4) casing steel, 630'
(material) (depth)

if telescope see back.
(size)

(5) screen 20, 630
(length) (depth to top)

2", stainless steel
(size) (material)

(6) pump 3, 60
(HP) (yield gpm)

(type power)

(7) electric log NO
(yes or no)

(organization running log)

(8) how well bottom plugged

DRILLERS REMARKS:

clay	0	25
fine sand	25	40
med sand	40	80
coarse sand	80	150
clay	150	220
sand	220	415
clay	415	620
med sand	620	650

COPIED


DEPT. OF NATURAL RESOURCES
BUREAU OF LAND & WATER RESOURCES

APR 28 1981

RECEIVED

If well telescopes please sketch and show depths.

GROUND LEVEL

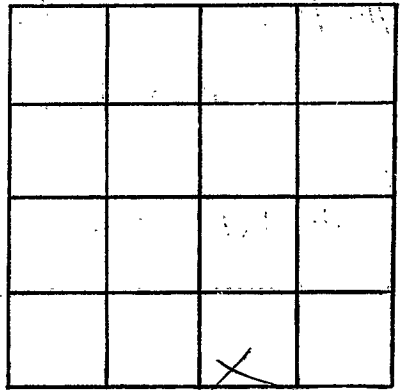

SECTION 32

Please indicate well location X.

ADDITIONAL INFORMATION

If more than one screen,
show locations of each on sketch.