

Sharkey
A63
4-9-80

MISSISSIPPI
BOARD OF WATER COMMISSIONERS
416 North State Street
Jackson, Mississippi 39201

CODED

WATER WELL DRILLERS LOG

Sharkey

Wash

4/9 1980 Dyer firm name
date well completed county well located

LANDOWNER:
M. P. NEFF
ARCOLA MS.
(mailing address)

description of formations encountered	from	to
Clay	0	2.8
Loam Sand	2.8	3.8
Sand	3.8	5.8
Sand + Gravel	5.8	9.5
Sand	9.5	10.3

WELL LOCATION:
sec. 10 T. 14 N. R. 6 E
S S
1 miles S of Delta City
(distance) (direction) (nearest town)

WELL PURPOSE: Domestic
(home, irrigation, municipal, industrial)


CODED

WELL COMPLETION DATA:

(1) diameter (inches) 12"
(2) total depth (feet) 103'
(3) static water level (feet) 19' below top of ground.
(4) casing Steel 103'
(material) (depth)
16" if telescope see back.
(size)
(5) screen 40' 63'
(length) (depth to top)
16" Steel
(size) (material)
(6) pump 40 2000
(HP) (yield gpm)
Diesel
(type power)
(7) electric log
(yes or no)


(organization running log)
(8) how well bottom plugged plate

DRILLERS REMARKS:

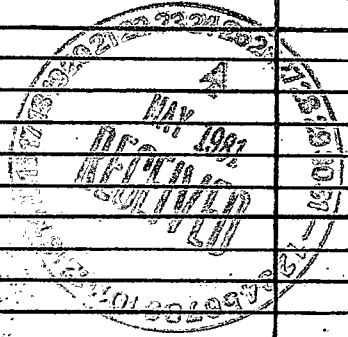

If well telescopes please sketch and show depths.

GROUND LEVEL

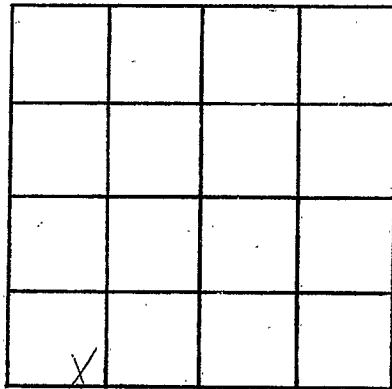

SECTION 10

Please indicate well location X.

ADDITIONAL INFORMATION

If more than one screen, show locations of each on sketch.