

Sharky
ALB
1-14-80

MISSISSIPPI
BOARD OF WATER COMMISSIONERS
416 North State Street
Jackson, Mississippi. 39201

CODED

WATER WELL DRILLERS LOG

Sharky
Wash

1/14 1980 date well completed
Dyer firm name
Wash county well located

LANDOWNER:
M. P. NEFF
Areola, MS.
(mailing address)

description of formations encountered	from	to
Clay	0	28
Fine sand	28	35
Sand	35	48
Sand & Gravel	48	113

WELL LOCATION:
sec. 10 T. 140 N R. 6 E
S W
1/4 miles from of Delta City
(distance) (direction) (nearest town)

WELL PURPOSE: Irrigation
(home, irrigation, municipal, industrial)

- WELL COMPLETION DATA:
- (1) diameter (inches) 16"
 - (2) total depth (feet) 113'
 - (3) static water level (feet) 19' below top of ground.
 - (4) casing Steel 113' (material) (depth)
16" (size) if telescope see back.
 - (5) screen 40' 73' (length) (depth to top)
16" Steel (size) (material)
 - (6) pump 60 3000 (HP) (yield gpm)
Diesel (type power)
 - (7) electric log (yes or no)
 - (organization running log)
 - (8) how well bottom plugged plate


CODED



DRILLERS REMARKS:

If well telescopes please sketch and show depths.

GROUND LEVEL

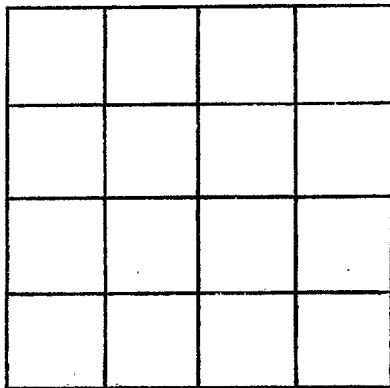

SECTION _____

Please indicate well location X.

ADDITIONAL INFORMATION

If more than one screen,
show locations of each on sketch.