

Sharkey  
A 66  
4-10-80

MISSISSIPPI  
BOARD OF WATER COMMISSIONERS  
416 North State Street  
Jackson, Mississippi 39201

CODED

WATER WELL DRILLERS LOG


4/10 1980  
date well completed

Dyer  
firm name

Sharkey  
county well located


| LANDOWNER:  | description of formations encountered | from | to |
|---|---------------------------------------|------|----|
| LEO WILLIAMS<br>DELTA CITY, MS.<br>(mailing address)                  |                                       |      |    |
| WELL LOCATION:  |                                       |      |    |
| sec. 4 T. 40 N. R. 6 W. S. Delta City                                 |                                       |      |    |
| 2 miles NW of Delta City<br>(distance) (direction) (nearest town)     |                                       |      |    |
| WELL PURPOSE: Irrigation<br>(home, irrigation, municipal, industrial) |                                       |      |    |
| WELL COMPLETION DATA:   |                                       |      |    |
| (1) diameter (inches) 16"   |                                       |      |    |
| (2) total depth (feet) 113'   |                                       |      |    |
| (3) static water level (feet) 20' below top of ground.                |                                       |      |    |
| (4) casing Steel 113'<br>(material) (depth)                           |                                       |      |    |
| 16" if telescope see back.<br>(size)                                  |                                       |      |    |
| (5) screen 40' 73'<br>(length) (depth to top)                         |                                       |      |    |
| 16" Steel<br>(size) (material)  |                                       |      |    |
| (6) pump 60 3000<br>(HP) (yield gpm)                                  |                                       |      |    |
| elective<br>(type power)  |                                       |      |    |
| (7) electric log (yes or no)  |                                       |      |    |
| (organization running log)  |                                       |      |    |
| (8) how well bottom plugged slate                                     |                                       |      |    |
| DRILLERS REMARKS:   |                                       |      |    |

CODED

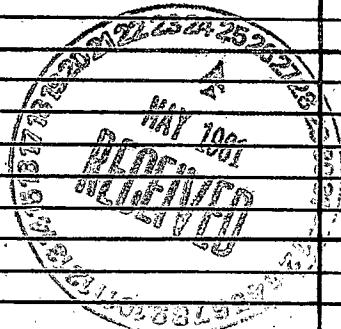

If well telescopes please sketch and show depths.

GROUND LEVEL

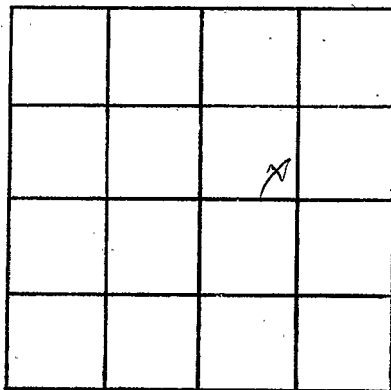

SECTION 7

Please indicate well location X.

ADDITIONAL INFORMATION

If more than one screen, show locations of each on sketch.