

MISSISSIPPI DEPARTMENT OF NATURAL RESOURCES

Bureau of Land and Water Resources

Southport Mall

P.O. Box 10631

Jackson, Mississippi 39209

WATER WELL DRILLERS LOG

Sharkey  
A 69  
10/23/81

CODED

10-23  
 date well completed

1981 Dyer Well & Irrigation  
 firm name

Sharkey  
Washington  
 county well located

LANDOWNER: R.W. Williams Est.

description of formations encountered

from

to

Hollandale, Ms.  
 (mailing address)

<u>Clay</u>	<u>0</u>	<u>26</u>
<u>Fine Sand</u>	<u>26</u>	<u>39</u>
<u>Sand &amp; gravel</u>	<u>39</u>	<u>108</u>
<u>Sand</u>	<u>108</u>	<u>113</u>

WELL LOCATION:

sec. 12 T. 14 (N) R. 6 E  
 S (W)  
2 miles SE of Delta City  
 (distance) (direction) (nearest town)

WELL PURPOSE: Irrigation  
 (home, irrigation, municipal, industrial)

WELL COMPLETION DATA:

- (1) diameter (inches) 16
- (2) total depth (feet) 113
- (3) static water level (feet) 21 below above top of ground.
- (4) casing Steel, 73,  
 (material) (depth)  
16 If telescope see back.  
 (size)
- (5) screen 46, 73  
 (length) (depth to top)  
16, Mild Steel  
 (size) (material)
- (6) pump 60 3000  
 (HP) (yield gpm)  
Diurnal  
 (type power)
- (7) electric log No  
 (yes or no)  
None  
 (organization running log)
- (8) how well bottom plugged Plate

CODED

DEPT. OF NATURAL RESOURCES  
 BUREAU OF LAND & WATER RESOURCES


MAY 19 1982

DRILLERS REMARKS:

RECEIVED

If well telescopes please sketch and show depths.

GROUND LEVEL

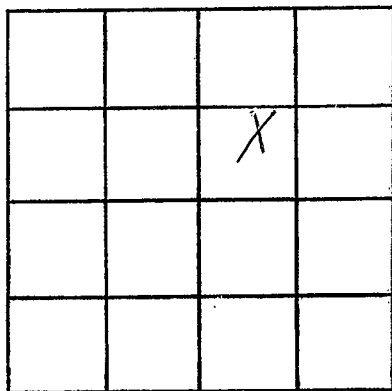

SECTION 12

Please indicate well location X.

ADDITIONAL INFORMATION

If more than one screen, show locations of each on sketch.