

MISSISSIPPI DEPARTMENT OF NATURAL RESOURCES

Bureau of Land and Water Resources

Southport Mall

P.O. Box 10631

Jackson, Mississippi 39209

WATER WELL DRILLERS LOG

Sharkey
A 70
4/14/82

CODED

date well completed April 14 1982 firm name Larry's Well & Pump county well located Sharkey

LANDOWNER: <u>Herman Cooper</u>	description of formations encountered	from	to
<u>Delta City, Miss</u> (mailing address)	<u>0-25 Clay</u> <u>25-35 fine sand</u> <u>35-50 med sand</u> <u>50-116 coarse silt</u>		
WELL LOCATION: sec. <u>9</u> T. <u>104</u> N R. <u>6</u> E <u>1</u> miles <u>W</u> of <u>Delta City</u> (distance) (direction) (nearest town)			
WELL PURPOSE: (home, irrigation, municipal, industrial)			
WELL COMPLETION DATA:			
(1) diameter (inches) <u>16"</u>			
(2) total depth (feet) <u>116'</u>			
(3) static water level (feet) <u>23</u> <u>below</u> above top of ground.			
(4) casing <u>Steel</u> <u>76'</u> (material) (depth)	CODED		
_____ if telescope see back. (size)			
(5) screen <u>40'</u> <u>76'</u> (length) (depth to top)			
_____ <u>Steel</u> (size) (material)			
(6) pump <u>60</u> <u>2800</u> (HP) (yield gpm)			
<u>Dsh Powermet</u> (type power)			
(7) electric log <u>NO</u> (yes or no)			
_____ (organization running log)			
(8) how well bottom plugged <u>Steel</u> <u>Plate</u>			
DRILLERS REMARKS:			


DEPT. OF NATURAL RESOURCES
 BUREAU OF LAND & WATER RESOURCES

JUN 30 1982

RECEIVED

If well telescopes please sketch and show depths.

GROUND LEVEL

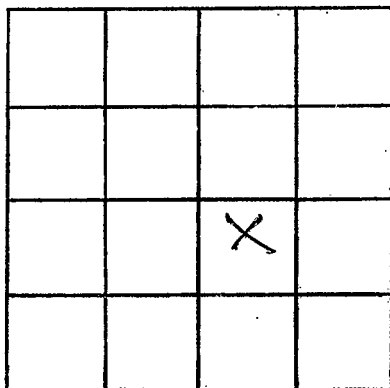

SECTION 9

Please indicate well location X.

ADDITIONAL INFORMATION

If more than one screen,
show locations of each on sketch.