

Sharkey

MISSISSIPPI DEPARTMENT OF NATURAL RESOURCES

Bureau of Land and Water Resources

Southport Mall

P.O. Box 10631

Jackson, Mississippi 39209

WATER WELL DRILLERS LOG

CODED

Sharkey Co.

A71

5-06-83

May 06 1983 date well completed

Larry's well & pump name

Sharkey Co. county well located

LANDOWNER: <u>Donall Just</u>	description of formations encountered	from	to
<u>Delta City, Ms</u> (mailing address)	<u>clay</u>	<u>6</u>	<u>20</u>
	<u>Sand</u>	<u>20</u>	<u>50</u>
	<u>Sand & gravel</u>	<u>50</u>	<u>103</u>

WELL LOCATION:

sec 22 T 14 N R 6 E
S W

2 miles South of Delta City
(distance) (direction) (nearest town)

WELL PURPOSE:
(home, irrigation, municipal, industrial)

WELL COMPLETION DATA:

(1) diameter (inches) 16"

(2) total depth (feet) 103'

(3) static water level (feet) 15 below above
top of ground.

(4) casing Steel, 63'
(material) (depth)

(size) if telescope see back.

(5) screen 40', 63'
(length) (depth to top)

16", Steel
(size) (material)

(6) pump 60 3000
(HP) (yield gpm)

0
(type power)

(7) electric log No
(yes or no)

(organization running log)

(8) how well bottom plugged Steel
Plate

CODED

DEPT. OF NATURAL RESOURCES
BUREAU OF LAND & WATER RESOURCES


SEP 26 1983

RECEIVED

DRILLERS REMARKS:

If well telescopes please sketch and show depths.

GROUND LEVEL

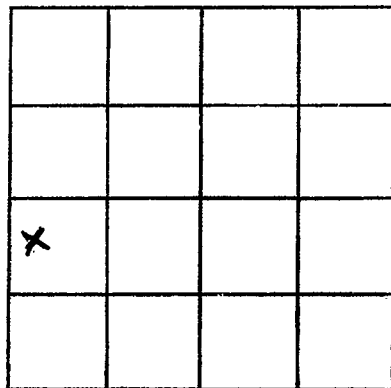

SECTION 22

Please indicate well location X.

ADDITIONAL INFORMATION

If more than one screen,
show locations of each on sketch.