

SHARKEY CO.
A 75
8-23-83

MISSISSIPPI DEPARTMENT OF NATURAL RESOURCES
Bureau of Land and Water Resources
Southport Mall
P.O. Box 10631
Jackson, Mississippi 39209
WATER WELL DRILLERS LOG

CODED

Aug 23 19 83 Larry's Well Pump Co Sharkey Co
date well completed firm name county well located

LANDOWNER: Clyde Perkins

description of formations encountered

from to

Rolling Fork Miss.
(mailing address)

clay	0	30
fine sand	30	60
coarse sand & gravel	60	113

WELL LOCATION:

sec. 4 T 14 N R E
S W
2 m miles west of Delta City
(distance) (direction) (nearest town)

WELL PURPOSE:

(home, irrigation, municipal, industrial)

WELL COMPLETION DATA:

(1) diameter (inches) 16"
(2) total depth (feet) 113
(3) static water level (feet) 28 below
top of ground.

(4) casing steel 73'
(material) (depth)

(size) if telescope see back.

(5) screen 40 73
(length) (depth to top)

16" steel
(size) (material)

(6) pump 40 2000
(HP) (yield gpm)

0
(type power)

(7) electric log no
(yes or no)

(organization running log)

(8) how well bottom plugged steel plate

DRILLERS REMARKS:

CODED


DEPT. OF NATURAL RESOURCES
BUREAU OF LAND & WATER RESOURCES

FEB 15 1984

RECEIVED

If well telescopes please
sketch and show depths.

GROUND LEVEL

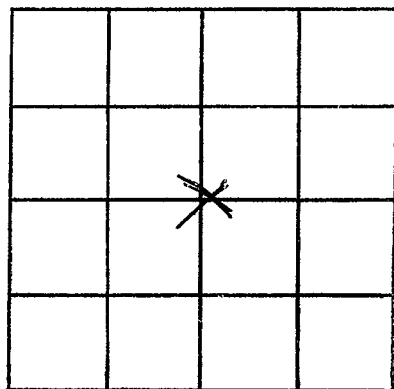

SECTION 4

Please indicate well location X.

ADDITIONAL INFORMATION

If more than one screen,
show locations of each on sketch.