

SHARKEY
A76

MISSISSIPPI DEPARTMENT OF NATURAL RESOURCES

Bureau of Land and Water Resources

Southport Mall

P.O. Box 10631

Jackson, Mississippi 39209

WATER WELL DRILLERS LOG

CODED

Apr 04 1986
date well completed

Larry's Well pump
firm name

Sharkey
county well located

LANDOWNER: Craig Boykin

description of formations encountered

from

to

Delta City, MS
(mailing address)

clay 0 30
Fine S and 30 50
coarse Sand & gravel 50 100

WELL LOCATION:

sec. 4 T. 14 N. R. 6 E.
S. W.
2 N miles 2 W of Delta City
(distance) (direction) (nearest town)

WELL PURPOSE:

(home, irrigation, municipal, industrial)

WELL COMPLETION DATA:

- (1) diameter (inches) 8"
(2) total depth (feet) 100'
(3) static water level (feet) 22 below above
top of ground.
(4) casing PVC, 60'
(material) (depth)
(size) If telescope see back.
(5) screen 40', 60'
(length) (depth to top)
8", PVC
(size) (material)
(6) pump 20, 1000
(HP) (yield gpm)

(type power)


(7) electric log NO
(yes or no)

(organization running log)

(8) how well bottom plugged PVC
cap

DRILLERS REMARKS:

CODED

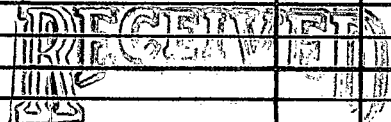

SEP 2, 1985

If well telescopes please
sketch and show depths.

GROUND LEVEL

X			

SECTION 4

Please indicate well location X.

ADDITIONAL INFORMATION

If more than one screen,
show locations of each on sketch.