

MISSISSIPPI DEPARTMENT OF NATURAL RESOURCES

Bureau of Land and Water Resources

Southport Mall

P.O. Box 10631

Jackson, Mississippi 39209

WATER WELL DRILLERS LOG

CODED

SHARKEY
A 78

D-49-87

7-8 1987 Dyer Well, Inc. Sharkey
date well completed firm name county well located

LANDOWNER: <u>Hill Farms, Inc</u>	description of formations encountered	from	to
<u>90 Joel Hill</u>			
<u>Anguilla Ms</u> (mailing address)	<u>Clay</u> <u>fine Sand</u> <u>Sand + Gravel</u>	<u>0</u> <u>30</u> <u>68</u>	<u>30</u> <u>68</u> <u>118</u>
WELL LOCATION: sec. <u>36</u> T. <u>14</u> (N) S R. <u>6</u> E (W) _____ miles of <u>Anguilla</u> (distance) (direction) (nearest town)			
WELL PURPOSE: <u>Sanitation</u> (home, irrigation, municipal, industrial)			
WELL COMPLETION DATA:			
(1) diameter (inches) <u>16"</u>			
(2) total depth (feet) <u>118</u>			
(3) static water level (feet) _____ below top of ground. above			
(4) casing <u>Steel</u> (material) (depth) <u>16"</u> if telescope see back. (size)			
(5) screen <u>40'</u> (length) (depth to top)			
(6) pump <u>60</u> <u>2800</u> (HP) (yield gpm)			
(7) electric log <u>No</u> (yes or no) <u>None</u> (organization running log)			
(8) how well bottom plugged <u>Plate</u>			
DRILLERS REMARKS:			

CODED


RECEIVED

AUG 05 1987

Department of Natural Resources
Bureau of Land & Water Resources

If well telescopes please
sketch and show depths.

GROUND LEVEL

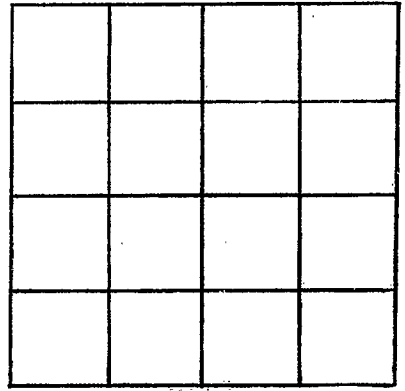

SECTION _____

Please indicate well location X.

ADDITIONAL INFORMATION

If more than one screen,
show locations of each on sketch.