

MISSISSIPPI DEPARTMENT OF NATURAL RESOURCES

Bureau of Land and Water Resources

COUNTY WELL LOCATED <i>Sharkey</i>	
WELL NUMBER <i>A 49</i>	CODED
DATE WELL COMPLETED <i>April 13, 1988</i>	

PERMIT NUMBER <i>MS GW 09610</i>
NAME OF DRILLING FIRM <i>Larry's well & pump</i>

CODED
P.O. Box 10631
Jackson, Mississippi 39209
WATER WELL DRILLERS LOG

NAME & MAILING ADDRESS OF LANDOWNER <i>Herman Cooper</i>		
WELL LOCATION: SEC. <i>3</i> TOWNSHIP <i>14</i> RANGE <i>6</i>		
DISTANCE <i>3</i> Miles <i>north</i> of <i>Delta city</i>		
OTHER LANDMARK		
WELL PURPOSE: Home <u>Irrigation</u> , Municipal, Industrial, Fish Pond, etc.		

PUMP DATA		
PUMP TYPE (Circle One): Submersible, <u>Turbine</u> , Jet, Flowing Well, Other (Describe)		
POWER TYPE (Circle One): Electric, Tractor, <u>Diesel</u> , Gasoline, Butane, Other (Describe)		
Pump Capacity (GPM) <i>300</i>	No. of Stages <i>1</i>	Setting Depth <i>60'</i> FT.
PUMP TEST Well yielded _____ GPM with a drawdown of _____ ft. after _____ hours of pumping		

WELL DATA		
Well Depth <i>122'</i>	Casing Diameter (In.) <i>16"</i>	Casing Length (Ft.) <i>82'</i>
Type of Casing <i>Steel</i>	Hole Depth <i>122'</i>	Depth to Static Water Level <i>20'</i>
TYPE OF COMPLETION: (Circle One or More): <u>Gravel Packed</u> , Underreamed, Telescoped, Natural Development, Open Hole, Other		
Top of Lap Pipe or Reduction in Casing FEET <input type="checkbox"/> IF TELESCOPED OR MORE THAN ONE SCREEN: USE BACK PAGE		


LOG DATA	
TYPE OF LOG RUN (Circle One): Electric, Gamma Ray, Density, Sonic, <u>No Log Run</u> , Other (Describe)	
Name of Organization Running Log	

SCREEN DATA		
Diameter - Inches <i>16"</i>	Length - Feet <i>40'</i>	Slot Size - Inches <i>.060</i>
Screen Type <i>Steel</i>	Depth to Bottom - Feet <i>122'</i>	

GEOLOGIC DATA (Office Use Only)			
Surface Elev.	Geologic Unit	Unit Thickness	Depth to Top
Subs. SWL	Date	Analysis	Aquifer Test

Driller's Remarks

DESCRIPTION OF FORMATIONS ENCOUNTERED	FROM	TO
<i>Clay</i>	<i>0</i>	<i>30</i>
<i>Fine Sand</i>	<i>30</i>	<i>70</i>
<i>Coarse Sand & gravel</i>	<i>70</i>	<i>122</i>

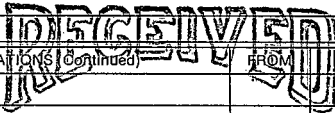

OCT 27 1988

Department of Natural Resources
Bureau of Land & Water Resources

FORMATIONS (Continued)	FROM	TO

IF MORE SPACE IS NEEDED, USE BACK

If well telescopes please sketch and show depths.

GROUND LEVEL

See Attachment #2
Sketch

			X

SECTION 3

Please indicate well location X.

ADDITIONAL INFORMATION

If more than one screen,
show location of each on sketch.
