

MISSISSIPPI DEPARTMENT OF NATURAL RESOURCES

Bureau of Land and Water Resources

Southport Mall

P.O. Box 10631

Jackson, Mississippi 39209

WATER WELL DRILLERS LOG

Permit Applied For A89

Weld 9002 Sharky A77

1/1 date well completed

1988 Dyer Well firm name

Sharky county well located

LANDOWNER Carlo Caselli

description of formations encountered

from	to
0	30
30	58
58	118

NITTA YUMA Ms (mailing address)

Clay Fine Sand Sand & gravel


WELL LOCATION:

sec 25 T 14 N R 7 E 3 miles W of NITTA YUMA (distance) (direction) (nearest town)

WELL PURPOSE: IRRIGATION (home, irrigation, municipal, industrial)

WELL COMPLETION DATA:

- (1) diameter (inches) 16"
- (2) total depth (feet) 118'
- (3) static water level (feet) _____ below above top of ground.
- (4) casing steel (material), (depth) 16 (size) if telescope see back.
- (5) screen 40 (length), (depth to top) 16 (size), (material)
- (6) pump 60 (HP), (yield gpm) Gear (type power)
- (7) electric log No (yes or no) None (organization running log)
- (8) how well bottom plugged Plate

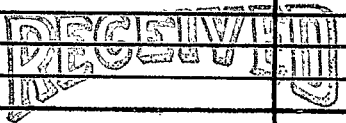


MAY 02 1988

Department of Natural Resources Bureau of Land & Water Resources

DRILLERS REMARKS:

If well telescopes please
sketch and show depths.

GROUND LEVEL

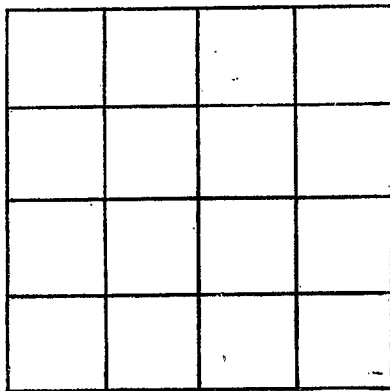

SECTION _____

Please indicate well location X.

ADDITIONAL INFORMATION

If more than one screen,
show locations of each on sketch.