

MISSISSIPPI DEPARTMENT OF ENVIRONMENTAL QUALITY

Office of Land and Water Resources

P. O. Box 10631
Jackson, MS 39289-0631
WATER WELL DRILLERS LOG

COUNTY WELL LOCATED
Sharkey

WELL NUMBER 1-192 CODED

DATE WELL COMPLETED
8-15-97

PERMIT NUMBER

NAME OF DRILLING FIRM
Schudeo Ltd

NAME & MAILING ADDRESS OF LANDOWNER
Pattin Farms
Wittayump MS
38763

WELL LOCATION: SEC 32 TOWNSHIP 14 RANGE 6
N S E W

DISTANCE 3 Miles DIRECTION NW of Anguilla

OTHER LANDMARK

WELL PURPOSE: Home Irrigation, Municipal, Industrial, Fish Pond, etc.

PUMP DATA

PUMP TYPE (Circle One):
 Submersible Turbine, Jet, Flowing Well,
Other (Describe) _____

POWER TYPE (Circle One):
 Electric, Tractor, Diesel, Gasoline, Butane,
Other (Describe) _____ H/P 2

Pump Capacity (GPM) 20 No. of Stages _____ Setting Depth 105 FT.

PUMP TEST

Well yielded _____ GPM with
a drawdown of _____ ft.
after _____ hours of pumping

WELL DATA

Well Depth <u>760</u>	Casing Diameter (In.) <u>4x2</u>	Casing Length (Ft.) <u>740</u>
Type of Casing <u>pvc</u>	Hole Depth	Depth to Static Water Level

TYPE OF COMPLETION: (Circle One or More):
 Gravel Packed, Underreamed, Telescoped,
 Natural Development, Open Hole, Other

WELL GROUTED TO A DEPTH OF 10 FEET
Type Grout (circle one): Cement, Bentonite, or Mix

LOG DATA

TYPE OF LOG RUN (Circle One): No Log Run
Electric, Gamma Ray, Density, Sonic, Neutron,
Other (Describe) _____

Name of Organization Running Log

SCREEN DATA

Diameter - Inches <u>2 in</u>	Length - Feet <u>20</u>	Slot Size - Inches <u>.008</u>
Screen Type <u>pvc</u>	Depth to Bottom - Feet <u>760</u>	

GEOLOGIC DATA (Office Use Only)

Surface Elev.	Geologic Unit	Unit Thickness	Depth to Top
Subs. SWL	Date	Analysis	Aquifer Test

Driller's Remarks

Top of Lap Pipe or Reduction in Casing


FEET IF TELESCOPED OR MORE THAN ONE SCREEN: USE BACK PAGE

DESCRIPTION OF FORMATIONS ENCOUNTERED	FROM	TO	FORMATIONS (Continued)	FROM	TO
<u>top soil</u>	<u>0</u>	<u>12</u>			
<u>sand</u>	<u>12</u>	<u>60</u>			
<u>sand + gravel</u>	<u>60</u>	<u>140</u>			
<u>gravel</u>	<u>140</u>	<u>170</u>			
<u>clay streaks + sand</u>	<u>170</u>	<u>220</u>			
<u>clay</u>	<u>220</u>	<u>460</u>			
<u>sand</u>	<u>460</u>	<u>640</u>			
<u>med. to coarse sand</u>	<u>640</u>	<u>760</u>			

05-10-98 ADG:33 RCVD

IF MORE SPACE IS NEEDED, USE BACK

If well telescopes please sketch and show depths.

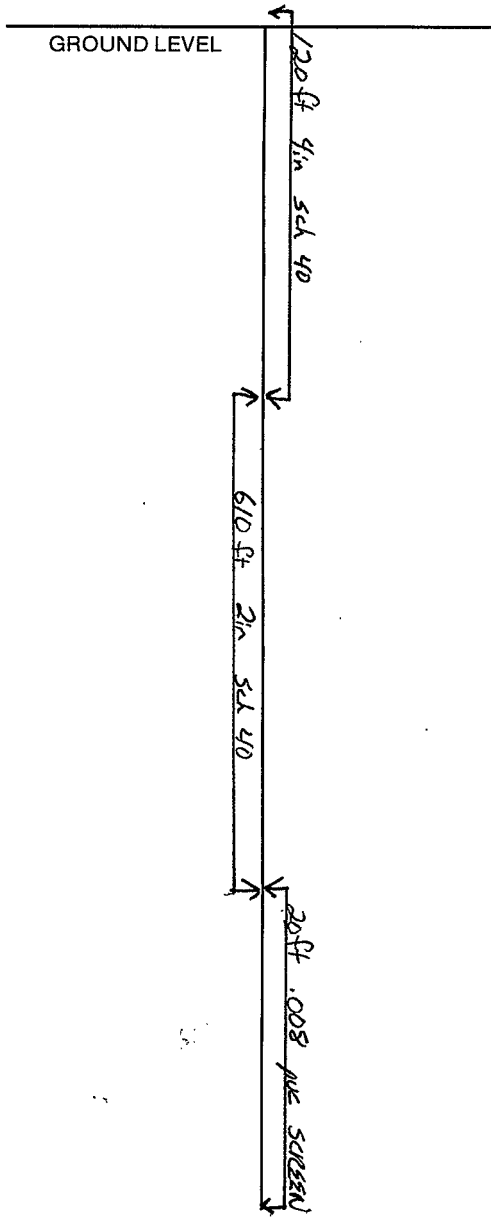

X			

SECTION 32

Please indicate well location X.

ADDITIONAL INFORMATION

Blank lined area for additional information.

If more than one screen, show location of each on sketch.