

MISSISSIPPI DEPARTMENT OF ENVIRONMENTAL QUALITY

Office of Land and Water Resources

P. O. Box 10631  
Jackson, MS 39289-0631  
WATER WELL DRILLERS LOG

COUNTY WELL LOCATED <i>Sharkey</i>	
WELL NUMBER <i>A-113</i>	CODED
DATE WELL COMPLETED <i>6-24-02</i>	

PERMIT NUMBER
NAME OF DRILLING FIRM <i>Schudco Ltd</i>

NAME & MAILING ADDRESS OF LANDOWNER <i>Durst and Durst Farms</i>			
<i>P.O. Box 156</i>			
<i>Anguilla MS, 38721</i>			
WELL LOCATION:	SEC	TOWNSHIP	RANGE
<i>500SE</i>	<i>34</i>	<i>27 N</i>	<i>14</i>
		<i>S</i>	<i>6</i>
			<i>E</i>
			<i>W</i>
DISTANCE	DIRECTION	NEAREST TOWN	
<i>4</i>	<i>South</i>	<i>Delta City</i>	
OTHER LANDMARK <i>33° 01' 32N 090° 48' 09W</i>			
WELL PURPOSE: Home, <u>Irrigation</u> , Municipal, Industrial, Fish Pond, etc. <i>Replacement well</i>			

PUMP DATA		
PUMP TYPE (Circle One): Submersible, Turbine, Jet, Flowing Well, Other (Describe) _____		
POWER TYPE (Circle One): Electric, Tractor, Diesel, Gasoline, Butane, Other (Describe) _____ H/P _____		
Pump Capacity (GPM)	No. of Stages	Setting Depth  FT.
PUMP TEST		
Well yielded _____ GPM with a drawdown of _____ ft. after _____ hours of pumping		

WELL DATA		
Well Depth <i>120</i>	Casing Diameter (In.) <i>16</i>	Casing Length (Ft.) <i>80</i>
Type of Casing <i>pvc</i>	Hole Depth <i>120</i>	Depth to Static Water Level <i>18 ft</i>

LOG DATA	
TYPE OF LOG RUN (Circle One): <u>No Log Run</u> Electric, Gamma Ray, Density, Sonic, Neutron, Other (Describe) _____	
Name of Organization Running Log	

TYPE OF COMPLETION: (Circle One or More):  
Gravel Packed, Underreamed, Telescoped,  
Natural Development, Open Hole, Other  
(Describe) \_\_\_\_\_

GEOLOGIC DATA (Office Use Only)			
Surface Elev.	Geologic Unit	Unit Thickness	Depth to Top
Subs. SWL	Date	Analysis	Aquifer Test

WELL GROUTED TO A DEPTH OF \_\_\_\_\_ FEET  
Type Grout (circle one): Cement, Bentonite, or Mix

Driller's Remarks	
Top of Lap Pipe or Reduction in Casing FEET IF TELESCOPED OR MORE THAN ONE SCREEN: USE BACK PAGE	

SCREEN DATA		
Diameter - Inches <i>16</i>	Length - Feet <i>40</i>	Slot Size - Inches <i>.035</i>
Screen Type <i>pvc</i>	Depth to Bottom - Feet <i>120</i>	


DESCRIPTION OF FORMATIONS ENCOUNTERED	FROM	TO	FORMATIONS (Continued)	FROM	TO
<i>clay</i>	<i>0</i>	<i>16</i>			
<i>fine sand</i>	<i>16</i>	<i>30</i>			
<i>fine to med sand</i>	<i>30</i>	<i>67</i>			
<i>course sand &amp; p-gravel</i>	<i>67</i>	<i>120</i>			

RECEIVED  
OCT 07 2002  
BY: OLWR

IF MORE SPACE IS NEEDED, USE BACK

If well telescopes please  
sketch and show depths.

GROUND LEVEL

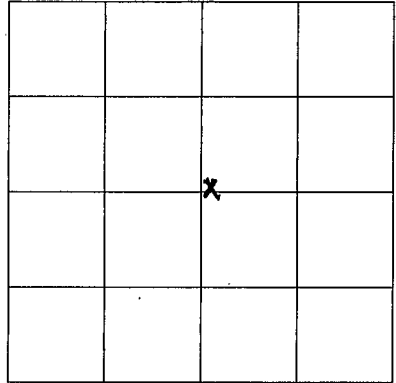

SECTION 34

Please indicate well location X.

ADDITIONAL INFORMATION

If more than one screen,  
show location of each on sketch.