		ell Report	For Office Use Only:	
County:Sharkey	Part 1			
Permit #: 6 W 41 664	Mississippi Department of Environmental Quality		Aquifer:	
Trrigation Fauinment	Office of Land and Water Resources P.O. Box 10631		Well #: <u>A-127</u>	
Driller:7-3-06		AS 39289-0631	L. S. Elevation:	
Date drilling completed:	(601))961-5210		
		4-6938 (fax)	E-log #:	
State Law requires that this repo		e driller in detail and filed w	ith the Department within	
30 days of completion of drilling of the well. Well Owner Information		Well Location		
Owner NameHollingsworth & Company		33 05 15. Latitude:	0 90 51 43. _" Longitude:	
Mailing Address: Box 248		Method of Lat/Long (circle one): Conventional Survey,		
			GPS, Survey-grade GPS	
Hollandale	MS 38748	$\frac{SW}{4} \frac{SW}{4} \frac$	Twn14N_Rng6W	
City Stat	e Zip Code	Distance Direction	Nearest Town	
Telephone No. (Miles North	of Panther Burn	
	Well	Data		
Purpose of Well (circle one) Home Indu	ustrial Public Supply	(Irrigation) Fish Culture	Other:	
			_	
Date well drilling started: $7-3-06$	Date	well drilling completed:/	-3-06	
If flowing, method of flow regulation: Val-	ve Other (o	Jescribe)		
Static Water Level:feet ab		-		
Static Water Level:feet ab	ove or below (circle one)	land surface Date measured:		
Method of Measurement (circle one) (sta	el tape electric tape	air line other:		
Hole depth: 125 Well dep	125	Wall amount of a doubt of	10 5	
	8	wen grouted to a depth of	<u>ice</u> ī	
Type of grout (circle one): Cement	Lentonit Mix			
Casing length: 85 feet Casin	a diameter 16	inches Type of cooring. P	VC Sch.40	
Screen length: <u>40</u> feet Scree	en diameter: <u>16</u>	inches Type of screen:	PVC Sch.40	
Screen slot size: . 050 inches	Setting depth: From	86 feet to	125 feet	
			-	
Type of completion (circle all applicable):	Gravel packed Under	rreamed Telescoped Open	hole Natural Development	
	Other (describe):			
Top of lap pipe or reduction in casing:	feet. If te	lescoped or more than one scr	een, describe on back of page	
Logs run (circle all applicable): No log run	e Electric Gamma Ray	Density Sonic Neutron	Other:	
Name of organization running log(s):				
	acted, and completed in	accordance with all applicable	requirements of the Mississip	
I certify that the well was drilled, constru			· · · ·	
I certify that the well was drilled, constru		partment of Health regulation	s and state laws.	
I certify that the well was drilled, constru Department of Environmental Quality and	nd/or the Mississippi De	partment of Health regulation	s and state lays.	
I certify that the well was drilled, constru	nd/or the Mississippi De	partment of Health regulation	s and state lays. MChun	


JUL 3 1 2006 BY: OLWR If well telescopes please sketch below and show depths.

Ground Level

Description of Formations Encountered	From To
Clay	037
Fine Sand	38 45
Fine Sand/gravel	46 55
Fine Sand/gravel Med. Sand/gravel	56 125

· • • • •

If more than one screen, show location of each on sketch

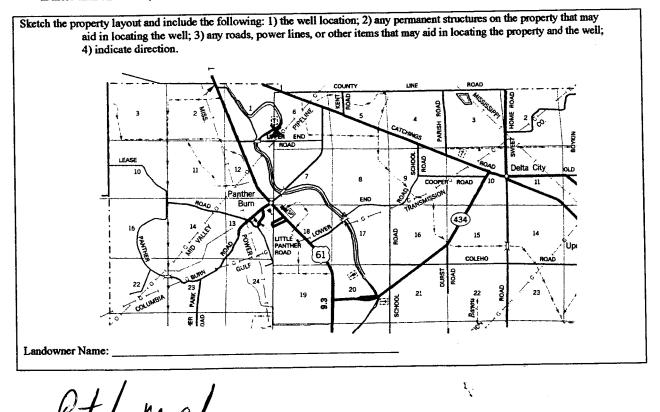

Signature of Water Well Contractor

STATE WELL REPORT						
County: Sharkey	Pa	art 2	For Office Use Only:			
Permit#: <u>6W41664</u> Irrigation Equipment	Pump Installer's Completion Report Mississippi Department of Environmental Quality		Aquifer.			
Driller:	Office of Land and Water Resources P.O. Box 10631 Jackson, MS 39289-0631		Well#: <u>A-127</u>			
Date completed: $7-3-06$	(601)	961-5210 4.6938 (far)	Elevation:			
Copy information from block on Part 1	(601)354-6938 (fax)					
This part of the report must be completed by a licensed water well contractor or a licensed pump installer. A copy of Part 1 of the report must be attached and both parts filed with the Department at the above address within 30 days of well completion.						
Well Owner Informat	lion	Wd	Location			
Owner Name:Hollingsworth	& Company	Latitude:	Longitude:			
Mailing Address: Box 248		Method of Lat/Long (check or	ne): Conventional Survey,			
		USGS quad, Hand-held GPS, Survey-grade GPS				
Hollandale	<u>MS 387</u> 48	<u>SW 14 SW 14 Sec</u>	<u>π</u> 14N R 6w			
City State	Zip Code	Distance Direction	Nearest Town			
Telephone No. ()	-	Mikes	f Panther Burn			
Pump Type Circle one		Power Type Circle one				
Air Lift Jet	Submersible	(Diesel Engine) Gasoli	ne Engine Natural Gas			
Bucket Piston (Turbine	Electric Motor Hand	Tractor PTO			
Centrifugal Rotary	Flowing Well	Windmill Other	(specify):			
Other (specify):	Horse Power Rating of Motor	60				
Date Pump Installed: 7-3-06 2500-3000		Setting Depth:	70 feet			
Rated Pump Capacity:	Gallons Per Minute	Number of Stages:1				
Pump Test Data			asuring Water Level			
Date Well Tested:		C	ircle one			
Static Water Level (A):Feet Below Land Surface		Air Line Electric Mea	0			
Pumping Water Level (B):Feet 1	Below Land Surface	Other (specify):				
Drawdown [(B) - (A)]:Feet Below Land Surface		For flowing well, measured st	nut in head:feet			
Test Pumping Rate:	Gallons Per Minute	Well yielded GPM with a drawdown of				
Duration of Pump Test (minimum 4 hours):	hours	feet after	hours of pumping			
I HEREBY CERTIFY that the above statements are true to the best of my forowledge. Patrick M. Chism 0695 Print Name of Pump Installer and License No. (if applicable) Signature of Pump Installer						

in the second

× 📣

Form: OLWR-SWR-1B RECEIVED

JUL 3 1 2006 BY: OLWR