Sharkey	State Wel	-	For Office Use Only:	
County:	Part 1 Mississippi Department of Environmental Quality		-	
Permit # 6 W 41575	Office of I and and		Aquifer: Well #: A - 133	
Irrigation Equipment	P.O. Box	Well #: <u>17 - 132</u>		
	Jackson, MS		L. S. Elevation:	
Date drilling completed: $3 - 2 - 07$	(601)96			
	(601)354-6	938 (fax)	E-log #:	
State Law requires that this repo 30 days of completion of drilling		iller in detail and filed w	ith the Department within	
Well Owner Informa		Well	Location	
Owner Name Patton Far		atitude:^	" Longitude:'	
Mailing Address: 27293 Hwy.61	N	fethod of Lat/Long (circle or	e): Conventional Survey,	
-		USGS quad, Hand-held	GPS, Survey-grade GPS	
		•		
Nitta Yuma	MS 30703	/4 <u>511</u> /4 <u>560</u> <u>20</u>	M <u></u> M <u>y</u> M	
•		Distance Direction Nearest Town		
Telephone No. ()	4871 _	<u> </u>	of <u>Anguilla</u>	
	Well Dat			
Purpose of Well (circle one) Home Ind	ustrial Public Supply	rigation Fish Culture	Other:	
	D / U		2 07	
Date well drilling started: $3 - 2 - 07$	Date well	drilling completed: <u>3 –</u>	2-07	
If flowing, method of flow regulation: Val	lve Other (desc	ribe)		
Static Water Level: 24 feet ab	ove or below (circle one) land	i surface Date measured:	3-5-07	
	\frown			
Method of Measurement (circle one)	eel tape electric tape	air line other.	<u> </u>	
Hole depth: <u>120</u> Well dep	oth: <u>120</u>	Well grouted to a depth of	10 feet	
	Bentonite Mix	_		
Casing length: <u>80</u> feet Casin	ng diameter: <u>12</u> in	nches Type of casing: _	VC 160	
Screen length: <u>40</u> feet Scree	en diameter: <u>12</u> i	inches Type of screen:	PVC 160	
Screen slot size: .050 inches	Setting depth: From	<u>31</u> feet to <u>1</u>	20 feet	
Type of completion (circle all applicable):	Gravel packed Underrea	med Telescoped Open	hole Natural Development	
	Other (describe):	l		
			. <u> </u>	
Top of lap pipe or reduction in casing:	feet. If teleso	coped or more than one scr	een, describe on back of page	
()	h Electric Gamma Ray I	Density Sonic Neutron	Other:	
Logs run (circle all applicable): No log pat				
Logs run (circle all applicable): No log part Name of organization running log(s): I certify that the well was drilled, constr	ucted, and completed in acc	ordance with all applicable	requirements of the Mississip	
Name of organization running log(s): I certify that the well was drilled, constr	_	\sim		
Name of organization running log(s): I certify that the well was drilled, constr Department of Environmental Quality a	nd/or the Mississippi Depar	\sim		
Name of organization running log(s): I certify that the well was drilled, constr	nd/or the Mississippi Depar	\sim		

.

MAR 2 6 2007 BY: OLWR

6.-

If well telescopes please sketch below and show depths.


Ground Level

Description of Formations Encountered	From	To
Clay	0	22
Fine Sand	23	45
Fine Sand/gravel	46	65
Fine Sand/gravel Fine Sand	66	74
Med. Sand/gravel	75	120
<u>dea.</u> Dana/graver		
	1	
	1	
		1
	+	
	+	
	+	<u> </u>
	-	+
		+
	+	
	+	<u> </u>
		ļ
	1	1

1. .

ر ر

If more than one screen, show location of each on sketch

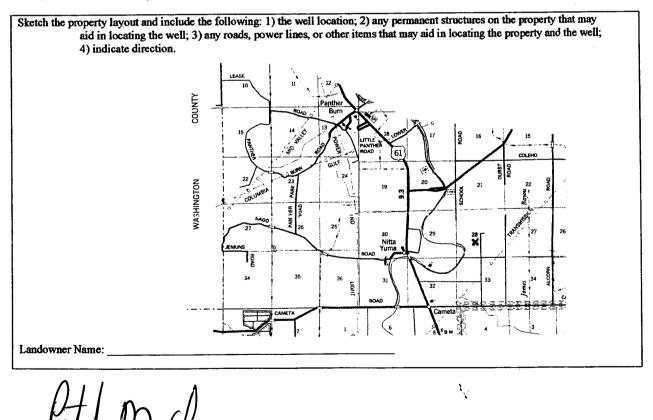

Signature of Water Well Contractor

STATE WELL REPORT					
County:Sharkey	Part 2 Pump Installer's Completion Report	For Office Use Only:			
Permit#: <u>6 W 4(575</u> Irrigation Equipment Date completed: 3-2-07	Mississippi Department of Environmental Quality Office of Land and Water Resources P.O. Box 10631 Jackson, MS 39289-0631 (601)961-5210	Aquifer: 			
	(601)354-6938 (fax)	Elevation:			

This report should be prepared by the pump installer in detail and filed with the Department within 30 days of the installation of pump.

Well Owner Information			Well Location				
Owner Name:	Patton Farms			Latitude: Longitude;			
Mailing Address:	27293 Hwy.61			Method of Lat/Long (circle one): Conventional Survey,			
	Nitta Y	Yuma MS 3	38763	USGS quad, Hand-held GPS, Survey-grade GPS NE 14 SW 14 Sec. 28 Twn ¹⁴ N _{Rng} 6W			
	City Stat 662-873-4			Distance Direction Nearest Town			
Telephone No. ()			<u>3</u> <u>Miles</u> <u>North</u> of <u>Anguilla</u>			

	Pump Type Circle one				r Type le one	
Air Lift	Jet	Submersible	Diesel Engine	Gasoline l	Engine	Natural Gas
Bucket	Piston	Turbine	Electric Motor	Hand		Tractor PTO
Centrifugal	Rotary	Flowing Well	Windmill	Other (sp	ccify):	
Other (specify):			Horse Power Ratin	g of Motor:	80	
Date Pump Installed:	3-5-	07	Setting Depth:		50	feet
Rated Pump Capacity:	1500	Gallons Per Minute	Number of Stages:	3		

Pump Test Data	Method of Measuring Water Level Circle one				
Date Well Tested:					
Static Water Level (A):Feet Below Land Surface Pumping Water Level (B):Feet Below Land Surface	Air Line Electric Measuring Line Steel Tape Other (specify):				
Drawdown [(B) (A)]:Feet Below Land Surface	For flowing well, measured shut in head:feet				
Test Pumping Rate:Gallons Per Minute	Well yielded GPM with a drawdown of				
Duration of Pump Test (minimum 4 hours):hours	feet afterhours of pumping				
I HEREBY CERTIFY that the above statements are true to the best of my knowledge.					
Patrick M. Chism 0695	Patrice VVI Ch				
Print Name of Pump Installer and License No. (if applicable)	Signature of Pump Installer				

1 1

v

MAR 2.6 2007 BY: OLWR

RECEIVED