

# State Well Report

## Part 1 - Driller's Log

Mississippi Department of Environmental Quality  
Office of Land and Water Resources  
P.O. Box 10631  
Jackson, MS 39289-0631  
(601)961-5210  
(601)354-6938 (fax)

County: Sharkey  
Permit #: 66042038  
Driller: Charles M. Nichols  
Date drilling completed: 6-12-07

For Office Use Only:  
Aquifer: \_\_\_\_\_  
Well #: A-141  
L. S. Elevation: \_\_\_\_\_  
E-log #: \_\_\_\_\_

**State Law requires that this report be prepared by the license holder responsible for the work and filed with the Department at the above address within 30 days of completion of drilling of the well or borehole.**

Information on Well Owner (Landowner if borehole is not for a water well)	Well or Borehole Location
Owner Name: <u>WC SKATES + SONS INC</u>	Latitude: <u>33° 03' 44"</u> Longitude: <u>90° 47' 36"</u>
Mailing Address: <u>P.O. Box 151</u>	Method of Lat/Long (circle one): Conventional Survey, _____ USGS quad, <u>Hand-held GPS</u> , Survey-grade GPS
<u>Axon</u> <u>MS</u> <u>38723</u>	<u>Sw 1/4 NW 1/4</u> Sec <u>14</u> Twn <u>14N</u> Rng <u>6W</u>
City State Zip Code	Distance Direction Nearest Town <u>1</u> Miles <u>South</u> of <u>Delta City</u>
Telephone No. ( ) _____	

**Well / Borehole Data**

Date drilling started: 6-12-07 Date drilling completed: 6-12-07 Hole depth: 110 Hole diameter: 26

Location of the source of any surface water used for drilling: Road ditch  
Method of dosing and volume of Chlorine used in drilling and development: H7H

Logs run (circle all applicable): No log run Electric Gamma Ray Density Sonic Neutron Other: \_\_\_\_\_  
Name of organization running log(s): \_\_\_\_\_

Purpose of borehole (check one): Water Well  Geotechnical/Geological Investigation \_\_\_\_\_ Ground Source Heat Pump \_\_\_\_\_  
Seismic Survey \_\_\_\_\_ Other (describe) \_\_\_\_\_

**If drilling is not related to water well construction, skip the remainder of this block**

Purpose of Well (check one): Home \_\_\_\_\_ Industrial \_\_\_\_\_ Public Supply \_\_\_\_\_ Irrigation  Fish Culture \_\_\_\_\_ Other: \_\_\_\_\_

If a flowing well, method of flow regulation: Valve \_\_\_\_\_ Other (describe) \_\_\_\_\_

Static Water Level: 24 feet above or below (circle one) land surface Date measured: 6-14-07

Method of Measurement (circle one) steel tape electric tape air line other: \_\_\_\_\_

Well depth: 110 Well grouted to a depth of 10 feet Type of grout (circle one): Neat Cement Bentonite Mix

Casing length: 70 feet Casing diameter: 16 inches Type of casing: pvc

Screen length: 40 feet Screen diameter: 16 inches Type of screen: pvc

Screen slot size: .035 inches Setting depth: From 70 feet to 110 feet

Type of completion (circle all applicable): Gravel packed Underreamed Telescoped Open hole Natural Development  
Other (describe): \_\_\_\_\_

Top of lap pipe or reduction in casing: \_\_\_\_\_ feet. *If telescoped or more than one screen, describe on next page*

Form: OLWR-SWR-1A

RECEIVED  
JUL 09 2007  
BY: OLWR

The sketch below only required for water wells

Description of formations encountered must be provided for all wells and boreholes, unless specifically exempted by regulations

If well telescopes, show depths on sketch.

Ground Level  $\rightarrow$


61042038



Description of Formations Encountered	From (depth)	To (depth)
	Ground Level	
Clay	0	20
Course sand	20	50
Course sand + p-gravel + gravel	50	110

If more than one screen, show location of each on sketch

Sketch the property layout and include the following: 1) the well location; 2) any permanent structures on the property that may aid in locating the well; 3) any roads, power lines, or other items that may aid in locating the property and the well; 4) a north arrow.

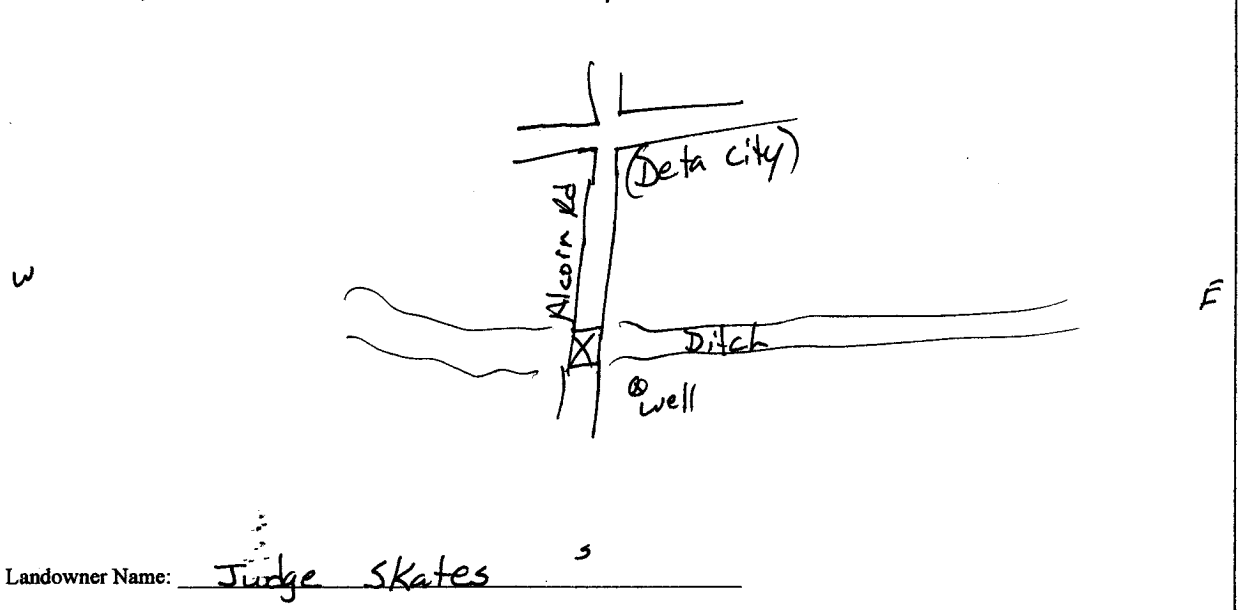

Form: OLWR-SWR-1A

I certify that the well/borehole was drilled, constructed, and completed in accordance with all applicable requirements of the Mississippi Department of Environmental Quality and the Mississippi Department of Health regulations, if applicable, and state laws.

Charles M. Nichols 0-0667 7-2-07

Charles M. Nichols (signature)

Print Name of Responsible Licensee and License No.

Date

Signature of Licensee

RECEIVED  
JUL 09 2007  
BY: OLWR

# STATE WELL REPORT

## Part 2

**Pump Installer's Completion Report**  
 Mississippi Department of Environmental Quality  
 Office of Land and Water Resources  
 P.O. Box 10631  
 Jackson, MS 39289-0631  
 (601)961-5210  
 (601)354-6938 (fax)

County: Sharkey  
 Permit #: OLW 42038  
 Driller: Charles M. Nichols  
 Date completed: 6-14-07  
*Copy information from block on Part 1*

**For Office Use Only:**

Aquifer: \_\_\_\_\_  
 Well #: A-141  
 Elevation: \_\_\_\_\_

*This part of the report must be completed by a licensed water well contractor or a licensed pump installer. A copy of Part 1 of the report must be attached and both parts filed with the Department at the above address within 30 days of well completion.*

Well Owner Information	Well Location
Owner Name: <u>WC SKATES + SONS INC</u>	Latitude: <u>33°03'44N</u> Longitude: <u>090°47'36W</u>
Mailing Address: <u>P.O. Box 151</u>	Method of Lat/Long (check one): Conventional Survey _____
<u>AYON MS 38723</u> City State Zip Code	USGS quad _____ Hand-held GPS <input checked="" type="checkbox"/> Survey-grade GPS _____
Telephone No. ( ) _____	<u>Sw 1/4 NW 1/4 Sec 14 T 14 R 6W</u>
	Distance Direction Nearest Town <u>1 Miles South of Delta City</u>

Pump Type Circle one	Power Type Circle one
Air Lift                      Jet                      Submersible	<u>Diesel Engine</u> Gasoline Engine                      Natural Gas
Bucket                      Piston <u>Turbine</u>	Electric Motor                      Hand                      Tractor PTO
Centrifugal                      Rotary                      Flowing Well	Windmill                      Other (specify): _____
Other (specify): _____	Horse Power Rating of Motor: <u>60</u>
Date Pump Installed: <u>6-14-07</u>	Setting Depth: <u>60</u> feet
Rated Pump Capacity: <u>3000</u> Gallons Per Minute	Number of Stages: <u>1</u>

Pump Test Data	Method of Measuring Water Level Circle one
Date Well Tested: _____	Air Line                      Electric Measuring Line <u>Steel Tape</u>
Static Water Level (A): <u>24</u> Feet Below Land Surface	Other (specify): _____
Pumping Water Level (B): _____ Feet Below Land Surface	For flowing well, measured shut in head: _____ feet
Drawdown [(B) - (A)]: _____ Feet Below Land Surface	Well yielded _____ GPM with a drawdown of _____ feet after _____ hours of pumping
Test Pumping Rate: <u>3000</u> Gallons Per Minute	
Duration of Pump Test (minimum 4 hours): _____ hours	

I HEREBY CERTIFY that the above statements are true to the best of my knowledge.

Charles M. Nichols 0-0667                      Charles M. Nichols  
 Print Name of Pump Installer and License No. (if applicable)                      Signature of Pump Installer

Form: OLWR-SWR-1B

RECEIVED

JUL 09 2007

BY: OLWR