

WATER #1  
**State Well Report**

Part 1

Mississippi Department of Environmental Quality  
 Office of Land and Water Resources  
 P.O. Box 10631  
 Jackson, MS 39289-0631  
 (601)961-5210  
 (601)354-6938 (fax)

For Office Use Only:

Aquifer: \_\_\_\_\_  
 Well #: A-144  
 L. S. Elevation: \_\_\_\_\_  
 E-log #: \_\_\_\_\_

County: SHARKEY  
 Permit #: GW42151  
 Driller: J. NEWCOMB  
 Date drilling completed: 9-10-07

State Law requires that this report be prepared by the driller in detail and filed with the Department within 30 days of completion of drilling of the well.

Well Owner Information	Well Location
Owner Name: <u>GAYLON LAWRENCE</u> <del>BRADTON LAWRENCE</del>	Latitude: <u>33° 01' 585"</u> Longitude: <u>090° 48' 754"</u>
Mailing Address: <u>PO BOX 532 PO BOX 5669</u> <u>GREENVILLE, MS</u> <u>38704-5669</u>	Method of Lat/Long (circle one): Conventional Survey, USGS quad <u>Hand-held GPS</u> , Survey-grade GPS <u>NW 1/4 NE 1/4 Sec 33 Twn 14N Rng 6W</u>
City: _____ State: _____ Zip Code: _____	Distance _____ Miles Direction _____ of Nearest Town _____
Telephone No: <u>662-820-8686</u>	<u>3</u> Miles <u>N</u> of <u>ANQUILLA</u>

**Well Data**

Purpose of Well (circle one) Home Industrial Public Supply Irrigation Fish Culture Other: \_\_\_\_\_

Date well drilling started: 9-10-07 Date well drilling completed: 9-10-07

If flowing, method of flow regulation: Valve \_\_\_\_\_ Other (describe) \_\_\_\_\_

Static Water Level: \_\_\_\_\_ feet above or below (circle one) land surface Date measured: \_\_\_\_\_

Method of Measurement (circle one) steel tape electric tape air line other: \_\_\_\_\_

Hole depth: 113 Well depth: 110 Well grouted to a depth of 10 feet

Type of grout (circle one): Cement Bentonite Mix

Casing length: 70 feet Casing diameter: 16 inches Type of casing: P. J. C.

Screen length: 40 feet Screen diameter: 16 inches Type of screen: P. J. C.

Screen slot size: .050 inches Setting depth: From 60-70 feet to 80-110 feet

Type of completion (circle all applicable): Gravel packed Underreamed Telescoped Open hole Natural Development  
 Other (describe): \_\_\_\_\_

Top of lap pipe or reduction in casing: \_\_\_\_\_ feet. If telescoped or more than one screen, describe on back of page

Logs run (circle all applicable): No log run Electric Gamma Ray Density Sonic Neutron Other: \_\_\_\_\_

Name of organization running log(s): \_\_\_\_\_

RECEIVED  
 SEP 21 2007  
 BY: OLWR


I certify that the well was drilled, constructed, and completed in accordance with all applicable requirements of the Mississippi Department of Environmental Quality and/or the Mississippi Department of Health regulations and state laws.

JOHN NEWCOMB 0-773  
 Print Name of Water Well Contractor and License No.

[Signature]  
 Signature of Water Well Contractor


If well telescopes please sketch below and show depths.


Ground Level

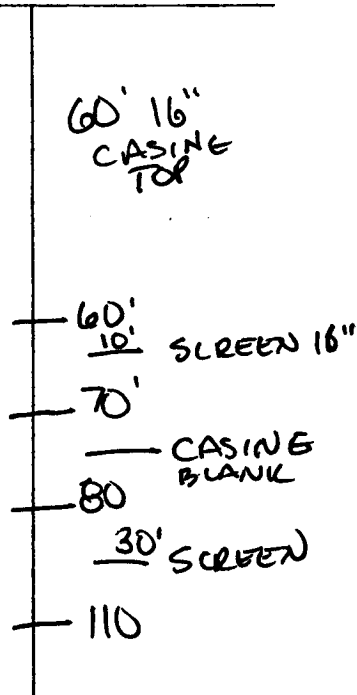

Description of Formations Encountered	From	To
0-10 TDP	0	10
MIX CLAY/FINE	10	40
FINE SAND	40	50
FINE/FAIR	50	60
FAIR SAND	60	70
FINE SAND	70	80
GOOD/PCA GRAVEL	80	110

If more than one screen, show location of each on sketch

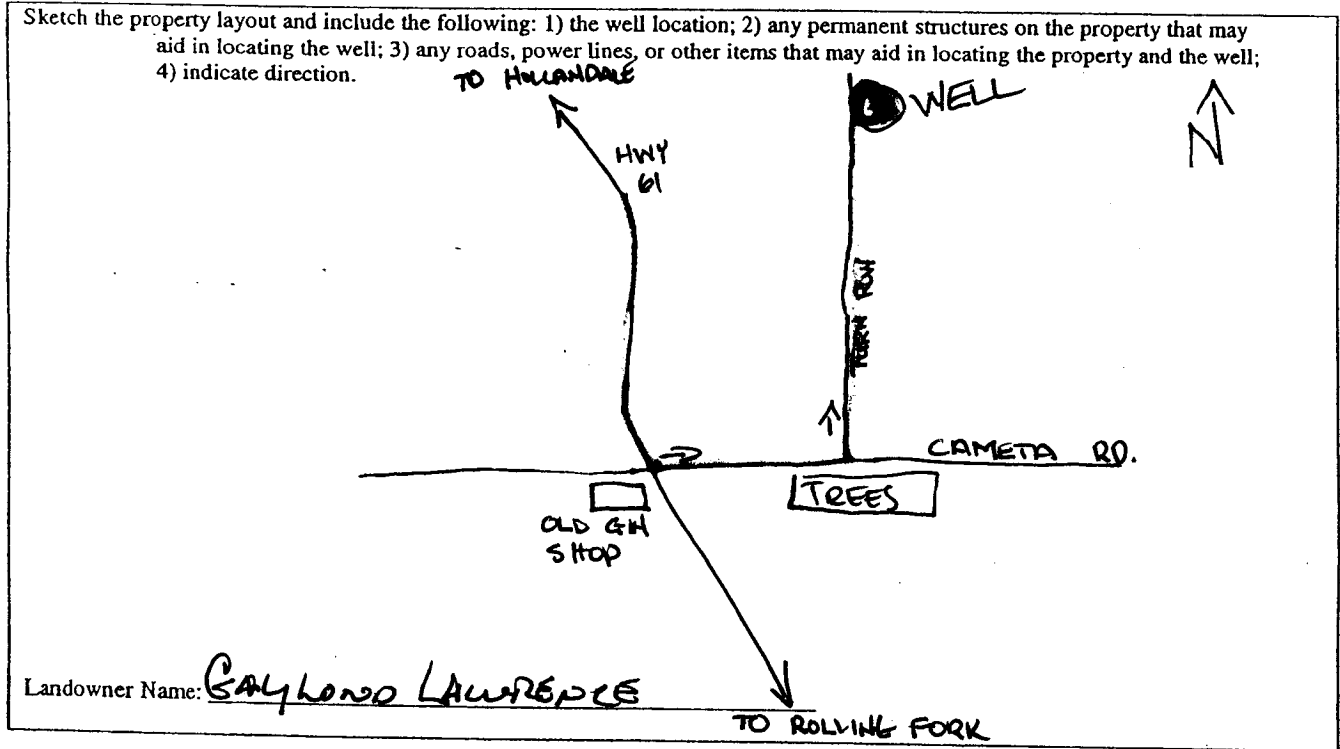

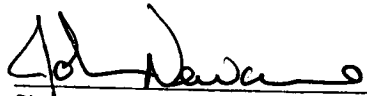  
 Signature of Water Well Contractor

Part 2

Pump Installer's Completion Report  
Mississippi Department of Environmental Quality  
Office of Land and Water Resources  
P.O. Box 10631  
Jackson, MS 39289-0631  
(601)961-5210  
(601)354-6938 (fax)

County: SHARKEY  
Permit #: 6W42151  
Driller: J. NEWCOME  
Date completed: 9-12-07

For Office Use Only:  
Aquifer: \_\_\_\_\_  
Well #: A-144  
Elevation: \_\_\_\_\_

This report should be prepared by the pump installer in detail and filed with the Department within 30 days of the installation of pump.

Well Owner Information	Well Location
Owner Name: <u>GAYLON LAWRENCE</u>	Latitude: <u>33-01-585</u> Longitude: <u>090-48-754</u>
Mailing Address: <u>PO Box 5669</u>	Method of Lat/Long (circle one): Conventional Survey.
<u>GREENVILLE, MS 38704</u>	USGS quad, <u>Hand-held GPS</u> , Survey-grade GPS
City State Zip Code	<u>NW 1/4 NE 1/4 Sec 33 Twn 14N Rng 6W</u>
Telephone No: <u>662-820-8686</u>	Distance Direction Nearest Town
	<u>3</u> Miles <u>N</u> of <u>ANDOLIKA</u>

Pump Type Circle one	Power Type Circle one
Air Lift Jet Submersible	<u>Diesel Engine</u> Gasoline Engine Natural Gas
Bucket Piston <u>Turbine</u>	Electric Motor Hand Tractor PTO
Centrifugal Rotary Flowing Well	Windmill Other (specify): _____
Other (specify): _____	Horse Power Rating of Motor: <u>600</u>
Date Pump Installed: <u>9-12-07</u>	Setting Depth: <u>600</u> feet
Rated Pump Capacity: <u>2000</u> Gallons Per Minute	Number of Stages: <u>1</u>

RECEIVED  
SEP 21 2007  
BY: OLWR

Pump Test Data	Method of Measuring Water Level Circle one
Date Well Tested: _____	Air Line Electric Measuring Line Steel Tape
Static Water Level (A): <u>No Test</u> Feet Below Land Surface	Other (specify): _____
Pumping Water Level (B): _____ Feet Below Land Surface	For flowing well, measured shut in head: _____ feet
Drawdown [(B) - (A)]: _____ Feet Below Land Surface	Well yielded _____ GPM with a drawdown of _____ feet after _____ hours of pumping
Test Pumping Rate: _____ Gallons Per Minute	
Duration of Pump Test (minimum 4 hours): _____ hours	

I HEREBY CERTIFY that the above statements are true to the best of my knowledge.  
GLEN ROWE #710-P  
Print Name of Pump Installer and License No. (if applicable) Signature of Pump Installer