# County: SHARKEY Permit #: 6 W 4 2 1 50 Driller: J. HEWCONE Date drilling completed: 9-7-07

### Bruron # 1 State Well Report

Part 1

Mississippi Department of Environmental Quality
Office of Land and Water Resources
P.O. Box 10631
Jackson, MS 39289-0631
(601)961-5210
(601)354-6938 (fax)

For Office Use Only:
Aquifer:
Well #: A - 145
L. S. Elevation:
E-log #:

State Law requires that this report be prepared by the driller in detail and filed with the Department within 30 days of completion of drilling of the well.


30 days of completion of drilling of the well.					
Well Owner Information	Well Location				
Owner Name BRUTON FARMS FTR	Latitude: 33 . 02 84 " Longitude 040 . 50 . 159"				
Mailing Address: 10 Box 522	Method of Lat/Long (circle one): Conventional Survey,				
. 1	USGS quad, Hand-held GPS, Survey-grade GPS				
1/2 20010	SW 1/4 NE 1/4 Sec 20 Twn 14N Rng 6W				
TOLLANDALE, IVIS. 30148	W 14 NE 14 Sec 20 Twn TIN Rng O TV				
City State Zip Code	Distance Direction Nearest Town				
Telephone 1002-378-6/48	5 Miles N of ANQUICA				
Well	Data				
Purpose of Well (circle one) Home Industrial Public Supply	Irrigation Fish Culture Other:				
0.7 1	9-7-07				
Date well drilling started: 9-7-07 Date	well drilling completed:				
If flowing, method of flow regulation: Valve Other (c	describe)				
Static Water Level:feet above or below (circle one)	land surface Date measured:				
Method of Measurement (circle one) steel tape electric tape	air line other:				
· · · · · · · · · · · · · · · · · · ·					
Hole depth: 103 Well depth: 100	_ Well grouted to a depth ofteet				
Type of grout (circle one): Cement Bentonite Mix	30				
Casing length: 60 feet Casing diameter: 16 inches Type of casing: 7.V.C.					
Screen length: 40 feet Screen diameter: 10 inches Type of screen: V.V.C.					
Screen slot size:, 050inches Setting depth: From 60 feet to feet					
Type of completion (circle all applicable) Gravel packed Under	erreamed Telescoped Open hole Natural Development				
Other (describe):					
Top of lap pipe or reduction in casing:feet. If	telescoped or more than one screen, describe on back of page				
Logs run (circle all applicable). No log run Electric Gamma Ra	y Density Sonic Neutron Other:				
Name of organization running log(s):					
I certify that the well was drilled, constructed, and completed in accordance with all applicable requirements of the Mississippi					
Department of Environmental Quality and/or the Mississippi Department of Health regulations and state laws.					
1 1 10 11					
JOHN NEWCOME 0-773	40 Akiren				
Print Name of Water Well Contractor and License No.	Signature of Water Well Contractor				

If well telescopes please sketch below and show depths.

Ground Level	 
	16" CASING
	 - 60°
	40° PVC 050 PVC
	 100

Description of Formations Encountered	From	То
TOP SOIL	0	10
MIX CLAT FINE CAND	10	40
FINE FAIR	40	ಖ
FAIR SAND	ಽು	<u>دن</u>
GOOD SAND	60	70
GOOD SAIND	70	غرع
COOD SAND   DEAGE.	හ	90
PER GRANZ GOOD STAND	90	100
FINE GCB	100	103

If more than one screen, show location of each on sketch

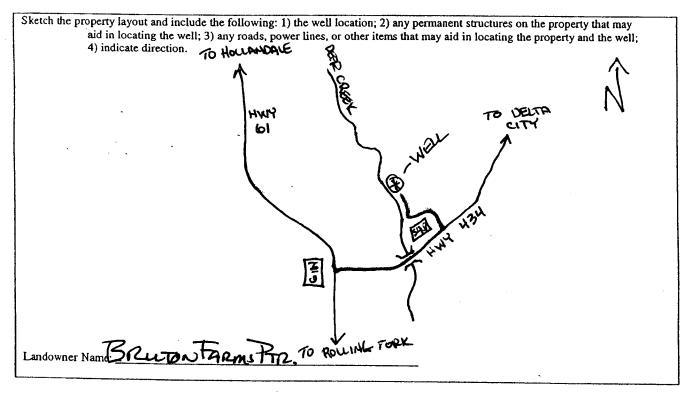

Signature of Water Well Contractor

## Permit #: 6 W 42150 Driller New Come Date completed: 9-7-07

#### DIALE WELL REPURI

#### Part 2

Pump Installer's Completion Report
Mississippi Department of Environmental Quality
Office of Land and Water Resources
P.O. Box 10631

P.O. Box 10631 Jackson, MS 39289-0631 (601)961-5210 (601)354-6938 (fax)

Fo	r Office I	Use Only:
Aquifer:		
Well #: _	A-	145
Elevation	:	

This report should be prepared by the pump installer in detail and filed with the Department within 30 days of the installation of pump

installation of pump.	and the Department within 50 days of the		
Well Owner Information	Well Location		
Owner Name Bruton Farms, Pra	Latitud 33-02-84 Longitud 090-50-159		
Mailing Address to Poox 522	Method of Lat/Long (circle one): Conventional Survey.		
//	USGS quad Hand-held GPS Survey-grade GPS		
HOCIANOSIE MC38748  City State Zip Code	SW1/NE 1/4 Sec 20 Twn 14N Rng 6W		
Telephone N6662-378-6148	Distance Direction Nearest Town		
Tecephotic Notice 278 VI78	5 Miles N of ANGUILLA		
Pump Type Circle one	Power Type Circle one		
Air Lift Jet Submersible	Diesel Engine Gasoline Engine Natural Gas		
Bucket Piston Turbine	Electric Motor Hand Tractor PTO		
Centrifugal Rotary Flowing Well	Windmill Other (specify):		
Other (specify):	Horse Power Rating of Motors O		
Date Pump Installed: 9-10-07	Setting Depth: 60 feet SEP		
Rated Pump Capacity Cool Gallons Per Minute	Number of Stages:		
	SWA		
Pump Test Data	Method of Measuring Water Level Circle one		
Date Well Tested:	Air Line Electric Measuring Line Steel Tape		
Static Water Level (A): Feet Below Land Surface	Other (specify):		
Pumping Water Level B) Feet Below Land Surface			
Drawdown [(B) - (A)]:Feet Below Land Surface	For flowing well, measured shut in head:feet		
Test Pumping Rate: Gallons Per Minute	Well yieldedGPM with a drawdown of		
Duration of Pump Test (minimum 4 hours):hours	feet afterhours of pumping		
I HEREBY CERTIFY that the above statements are true to the best of my knowledge.			
Print Name of Pump Installer and License No. (if applicable)	they give		
dividual and License No. (II applicable)	Signature of Pump Installer		