
*			
·	PAUL HOI		
<u> </u>	State We	ll Report	For Office Use Only:
ounty: SHARKEY	Part 1		$() H^{\dagger}$
ounty: Striking 7 GI	Mississippi Department	of Environmental Quality	Aquifer:
ermit # 611 43965	Office of Land an	d Water Resources	Well #: <u>A 205</u>
Driller. J. HEWCOME 0-773	P.O. Box 10631 Jackson, MS 39289-0631		L. S. Elevation:
Date drilling completed: 3-11-10		61-5210	
Date drilling completed:	(601)354	-6938 (fax)	E-log #:
State Law requires that this rep	port be prepared by the	driller in detail and filed v	with the Department within
30 days of completion of drilling of the well. Well Owner Information		We	Il Location 48
		33. 42.57	" Longitude: 90 . 40 . 14
Wher Name Hollis Ferry	<u>15</u>	Latitude: 33 ° 05 ° 35	
Mailing Address: P. O. Box	240	Method of Lat/Long (circle of	one): Conventional Survey,
Mailing Address:			ld GPS) Survey-grade GPS
	A	USGS quad, Hand-he	
Anavilla	INS SOLD	5x4 1/4 St 1/4 Sec_12	Twn 14N Rng low
City U S	MS 38721 State Zip Code	Dinning Dinning	Negrest Town
Telephone No. (G) 873 -	6967	Distance Direction 75 Miles Sodt	of Delta City
Telephone No. (200) 0 15			/
	Well	Data	
	r i i i Dublia Cumplu	Fish Culture	Other:
Purpose of Well (circle one) Home	industrial Public Supply		
Date well drilling started: $3 - 11 - 3$	/ð Date	well drilling completed:	
t.		(describe)	
If flowing, method of flow regulation:	Valve Other ((usullo)	
Static Water Level:fee	t above or below (circle one)) land surface Date measure	.d:
Method of Measurement (circle one)	•		r 12" m
Hole depth: 123 Wel	1 depth: 120	Well grouted to a depth of	offeet
Transformer (see) Comment	Bentonite) Mi	x	
Type of grout (circle one): Cement	. /		P. /
Casing length:feet (inches Type of casing	FVC
Screen length: <u>40</u> feet		inches Type of screen	
Screen length:feet	Screen diameter: 1		_
Screen slot size: .050 incl	hes Setting depth: From	1feet to	feet
		ierreamed Telescoped O	men hole Natural Developmen
Type of completion (circle all applical	Die): Oravel packed Und	retreation repropria o	L noteLunou
	Other (describe):		
	·	f talacconad or more than one	screen, describe on back of nag
Top of lap pipe or reduction in casing	ieet. I	I REFERENCE OF THOSE OF THE OFF	
Logs run (circle all applicable): No le	og run Electric Gamma R	ay Density Sonic Neutro	on Other:
Name of organization running log(s):		·	
Name of organization running log(s): I certify that the well was drilled, c	onstructed, and completed	in accordance with all applic	able requirements of the Mississi
Department of Environmental Qua	lity and/or the Mississippi	Department of Health regula	tions and state laws.
		1 N-	
JOHN NEWCOME	0-773	Jol	-Newcorners
	- No	Signah	ure of Water Well Contractor
Print Name of Water Well Contracto	or and License No.	10181101	APR 172
			MALAIT
			av. All
			2007A W 1 (14)

BY: OLWR

A205

If well telescopes please sketch below and show depths.

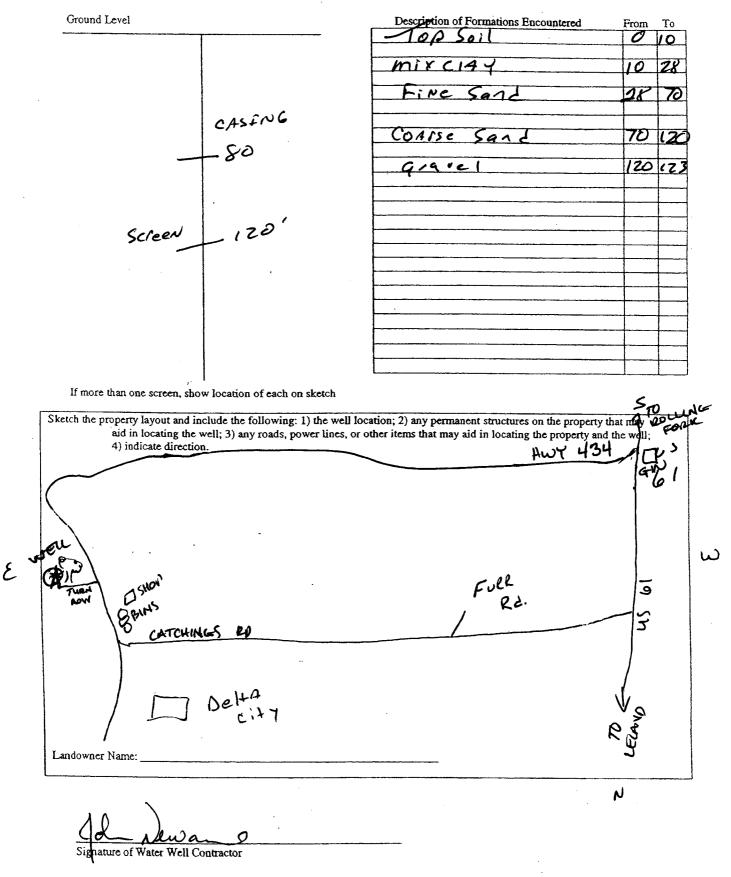

....

	1	ELL REPORT Part 2		
County: Sharkey	Pump Installer	's Completion Report	For Office Use Only:	
Permit #:	Mississippi Department of Environmental Quality Office of Land and Water Resources		Aquifer. BITT	
Driller: J. Newcome 0-	ГГЗ Р.О.	Box 10631		
Date completed: 3/11110	Jackson, MS 39289-0631 (601)961-5210		Well #: <u>A205</u>	
	(601)354-6938 (fax)		Elevation:	
This report should be prepared by th installation of pump.		ail and filed with the Departm	ent within 30 days of the	
Well Owner Information		Well Location		
Owner Name: Hollis Ferres		Latitude: 33° 03 '53	"Longitude:090 54 14	
Mailing Address: Hollis Farms		Method of Lat/Long (circle one): Conventional Survey,		
GI Carter Dr.		USGS quae Hand-held GPS. Survey-grade GPS		
Rolling Fork MS 39159 City State Zip Code		NW NE 15 Twn YW Rng Cold		
leiephone No. (1) 015-6	161	<u>Miles</u>	of Detta City	
Pump Type		P	ower Type	
Circle one			Circle one	
Air Lift Jet	Submersible	Diesel Eugine Gasol	line Engine Natural Gas	
Bucket Piston	Turbine	Electric Motor Hand	Tractor PTO	
Centrifugal Rotary	Flowing Well	Windmill Othe	r (specify):	
Other (specify):	- -	Horse Power Rating of Moto	\bigcirc	
Date Pump Instalied: 3/15710				
			feet	
Rated Pump Capacity: 200	_Gallons Per Minute	Number of Stages:		
Pump Test Data		Method of M	leasuring Water Level	
Date Well Tested:			Circle one	
Static Water Level (A):Feet		Air Line Electric Me	easuring Line Steel Tape	
		Other (specify):		
Pumping Water Level (B):Feet				
Drawdown [(B) - (A)]: Feet		For flowing well, measured	shut in head:feet	
Test Pumping Rate:	_Gallons Per Minute		GPM with a drawdown of	
Duration of Pump Test (minimum 4 hours)				
	uouts		hours of pumping	
	······································		<u> </u>	
HEREBY CERTIFY that the showe states	nente are mus to she h	of man low out the		
I HEREBY CERTIFY that the above stater	nents are true to the best	of my knowledge.		
I HEREBY CERTIFY that the above stater CON Rowe Print Name of Pump Installer and License I	1-711P	of my knowledge. Signature of Pump	Quy	

۶

BY: OLWR