

C.S. SMITH #4
EAST CAMBRIA RD.

GW45819

County: Sharkey
 Permit #: GW-45824
 Driller: J. NEWCOME O-773
 Date drilling completed: 4.28.2012

State Well Report
Part 1 - Driller's Log

Mississippi Department of Environmental Quality
 Office of Land and Water Resources
 P.O. Box 2309
 Jackson, MS 39225
 (601)961-5210
 (601)961-5228 (fax)

For Office Use Only:
 Aquifer: A 214
 Well #: _____
 L. S. Elevation: _____
 E-log #: _____

State Law requires that this report be prepared by the license holder responsible for the work and filed with the Department at the above address within 30 days of completion of drilling of the well or borehole.

Information on Well Owner (Landowner if borehole is not for a water well)	Well or Borehole Location
Owner Name: <u>Cand S Smith Farms Inc.</u>	Latitude: <u>33° 00' 41"</u> Longitude: <u>90° 48' 45"</u>
Mailing Address: <u>P.O. Box 534</u>	Method of Lat/Long (circle one): Conventional Survey, <input checked="" type="checkbox"/> Hand-held GPS, <input checked="" type="checkbox"/> Survey-grade GPS
<u>Anguilla MS 38721</u>	USGS quad: <u>SW 1/4 SW 1/4 Sec 34 Twn 14N Rng 06W</u>
City: _____ State: _____ Zip Code: _____	Distance: <u>4.5</u> Miles Direction: <u>N.E.</u> of Nearest Town: <u>ANGUILLA</u>
Telephone No. () _____	

Well / Borehole Data

Date drilling started: 4.28.12 Date drilling completed: 4.28.12 Hole depth: 110 Hole diameter: 24"

Location of the source of any surface water used for drilling: DITCH

Method of dosing and volume of Chlorine used in drilling and development: CHLORINE TABLETS

Logs run (circle all applicable): No log run Electric Gamma Ray Density Sonic Neutron Other: _____

Name of organization running log(s): _____

Purpose of borehole (check one): Water Well Geotechnical/Geological Investigation _____ Ground Source Heat Pump _____

Seismic Survey _____ Other (describe) _____

If drilling is not related to water well construction, skip the remainder of this block

Purpose of Well (check one): Home _____ Industrial _____ Public Supply _____ Irrigation Fish Culture _____ Other: _____

If a flowing well, method of flow regulation: Valve _____ Other (describe) _____

Static Water Level: _____ feet above or below (circle one) land surface Date measured: _____

Method of Measurement (circle one) steel tape electric tape air line other: _____

Well depth: 110 Well grouted to a depth of 10 feet Type of grout (circle one): Neat Cement Bentonite Mix

Casing length: 70 feet Casing diameter: 16 inches Type of casing: P.V.C.

Screen length: 40 feet Screen diameter: 16 inches Type of screen: P.V.C.

Screen slot size: .050 inches Setting depth: From 70 feet to 110 feet

Type of completion (circle all applicable): Gravel packed Underreamed Telescoped Open hole Natural Development

Other (describe): _____

Top of lap pipe or reduction in casing: _____ feet. *If telescoped or more than one screen, describe on next page*

Form: OLWR-SWR-1A (04/08)

RECEIVED

JUN 18 2012

By: OLWR

A214

GW45819

STATE WELL REPORT

Part 2

Pump Installer's Completion Report
Mississippi Department of Environmental Quality
Office of Land and Water Resources
P.O. Box 2309
Jackson, MS 39225
(601)961-5210
(601)961-5228 (fax)

County: Sharkey
 Permit #: GW-45824
 Driller: J Newcome 0-773
 Date completed: 4-28-2012
Copy information from block on Part 1

For Office Use Only:
 Aquifer: _____
 Well #: A214
 Elevation: _____

This part of the report must be completed by a licensed water well contractor or a licensed pump installer. A copy of Part 1 of the report must be attached and both parts filed with the Department at the above address within 30 days of well completion.

Well Owner Information	Well Location
Owner Name: <u>Cand J Smith Farms Inc.</u>	Latitude: <u>33°00'41"</u> Longitude: <u>90°48'45"</u>
Mailing Address: <u>P.O. Box 534</u>	Method of Lat/Long (check one): Conventional Survey _____
<u>Anguilla MS 38721</u>	USGS quad _____, Hand-held GPS <input checked="" type="checkbox"/> , Survey-grade GPS _____
City State Zip Code	<u>SW 1/4 SW 1/4 Sec 34 T 14N R 06W</u>
Telephone No. () _____	Distance Direction Nearest Town <u>4.5 Miles N.E. of Anguilla</u>

Pump Type			Power Type		
Circle one			Circle one		
Air Lift	Jet	Submersible	<u>Diesel Engine</u>	Gasoline Engine	Natural Gas
Bucket	Piston	<u>Turbine</u>	Electric Motor	Hand	Tractor PTO
Centrifugal	Rotary	Flowing Well	Windmill	Other (specify): _____	
Other (specify): _____			Horse Power Rating of Motor: <u>60</u>		
Date Pump Installed: <u>4/29/12</u>			Setting Depth: <u>70</u> feet		
Rated Pump Capacity: <u>2000</u> Gallons Per Minute			Number of Stages: <u>2</u>		

Pump Test Data	Method of Measuring Water Level
	Circle one
Date Well Tested: _____	Air Line
Static Water Level (A): _____ Feet Below Land Surface	Electric Measuring Line
Pumping Water Level (B): _____ Feet Below Land Surface	Steel Tape
Drawdown [(B) - (A)]: _____ Feet Below Land Surface	Other (specify): _____
Test Pumping Rate: _____ Gallons Per Minute	For flowing well, measured shut in head: _____ feet
Duration of Pump Test (minimum 4 hours): _____ hours	Well yielded _____ GPM with a drawdown of _____ feet after _____ hours of pumping

This is for (circle one): New Well Replacement of Existing Pump Repair of Existing Pump

I HEREBY CERTIFY that the above statements are true to the best of my knowledge.

Cory Rowe 0-711P _____
 Print Name of Pump Installer and License No. (if applicable) Signature of Pump Installer

RECEIVED
JUN 18 2012


BY: OLWR

A214



MARIS
Online Maps

Internet Mapping Framework

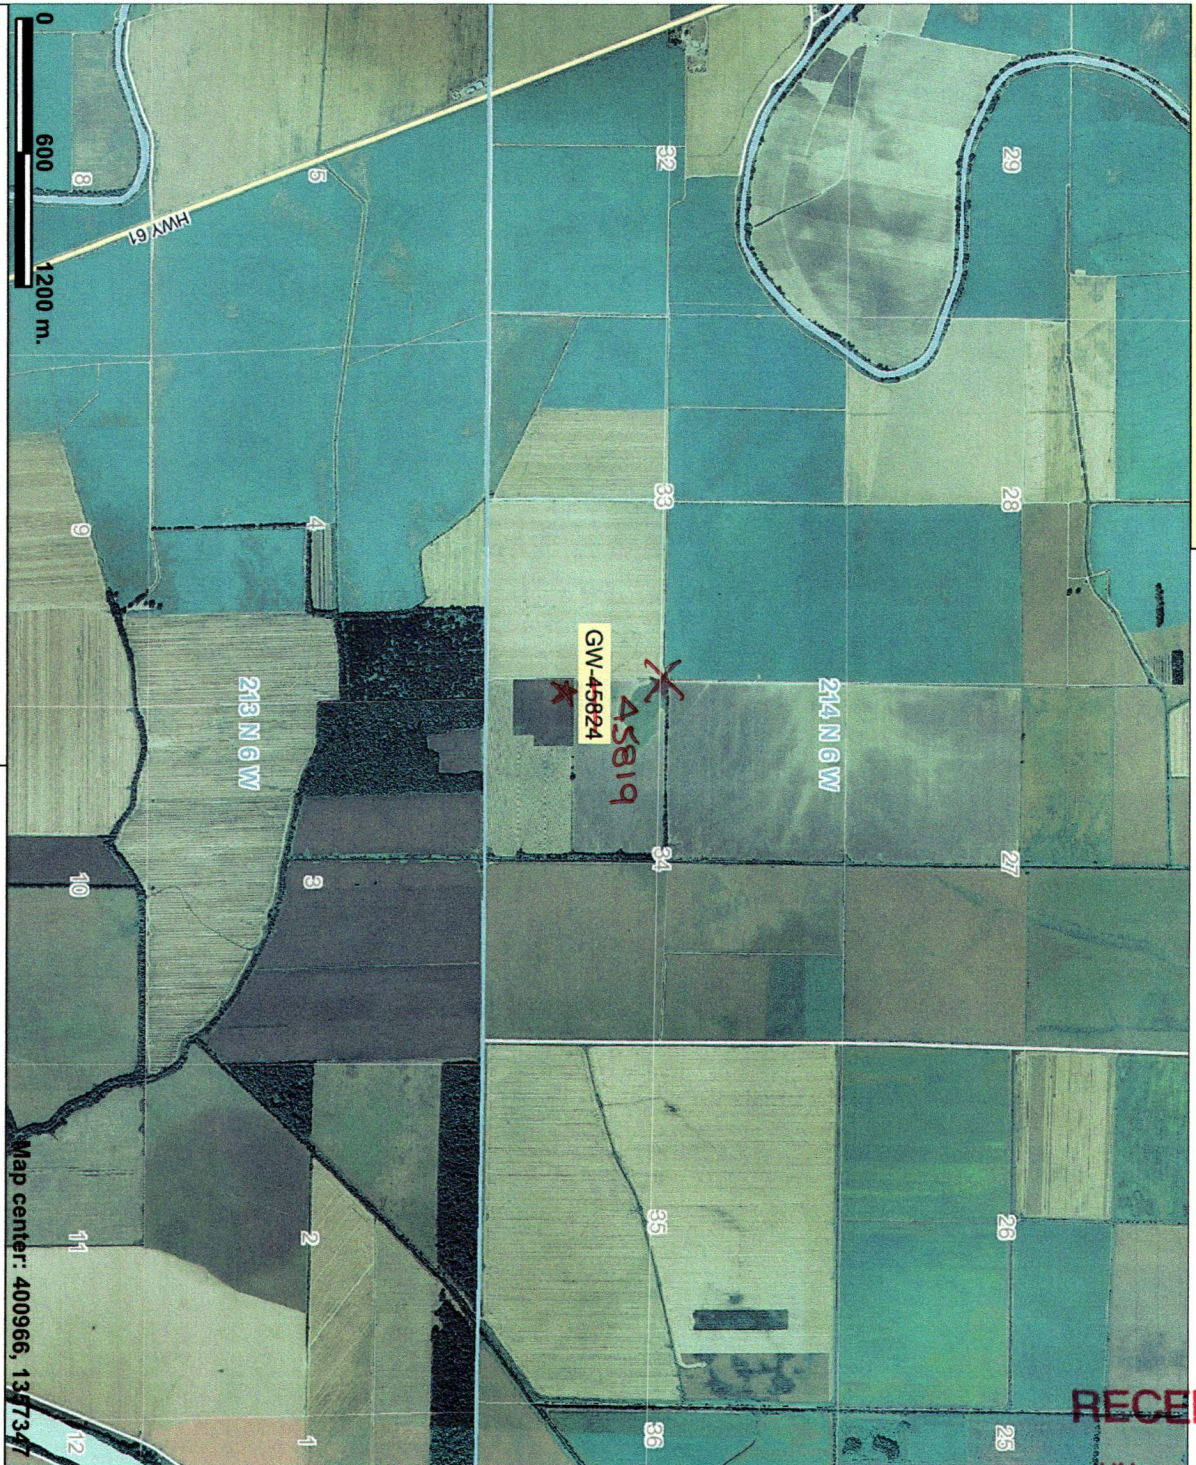

RECEIVED
JUN 18 2012

BY: OLWR



Legend

- County Boundaries
- Township
- Public Land Survey System
- MS One Call Natchez Trace Parkway
- MS One Call Interstate Highway
- MS One Call US / State Highway
- MS One Call 3 digit State Highway
- MS One Call County Roads and Streets
- Incorporated Cities
- Other Urban (non-incorporated)
- NHD Other Areas (dbl streams and Inun)
- adams07_m.sid
- alcorn07_m.sid
- amite07_m.sid
- attala07_m.sid
- benton07
- bolivar07_m.sid
- calhoun07_m.sid
- carroll07_m.sid
- chickasaw07_m.sid
- choctaw07_m.sid
- claborn07_m.sid
- clarke07_m.sid



Scale: 1:32,889



This map is a user generated static output from an Internet mapping site and is for general reference only. Data layers that appear on this map may or may not be accurate, current, or otherwise reliable. THIS MAP IS NOT TO BE USED FOR NAVIGATION.