

Sharkou

MISSISSIPPI
BOARD OF WATER COMMISSIONERS
416 North State Street
Jackson, Mississippi 39201

WATER WELL DRILLERS LOG

A 2001

7-16-80

Jan 16

date well completed

1980 Harry's Well & Pump Sharkou

firm name

county well located

LANDOWNER: Mrs. Phelps

description of formations encountered

from to

(mailing address)

WELL LOCATION:

sec. 29 T 14 N R. 6 E

0 miles 0 of Nitta Yuna (distance) (direction) (nearest town)

WELL PURPOSE: home (home, irrigation, municipal, industrial)

WELL COMPLETION DATA: 105-411

- (1) diameter (inches) 4" x 2"
- (2) total depth (feet) 903'
- (3) static water level (feet) 29' below top of ground.
- (4) casing steel, 833' (material) (depth)

(size) if telescope see back.

- (5) screen 10' (length), 833' (depth to top)

- (6) pump 2 (size), Plastic (material), 20 (yield gpm)

(type power)

- (7) electric log (yes or no)

(organization running log)

- (8) how well bottom plugged wash plug

clay	0'	20'
br clay	20'	38'
clay to sand	38'	55'
lime sand	55'	80'
sm gravel	80'	180'
white sand	180'	240'
sand to clay	240'	320'
clay	320'	420'
clay to sand	420'	615'
sand to clay	615'	680'
sand	680'	700'
sand + clay	700'	740'
clay to sand	740'	775'
clay	775'	840'
clay to sand	840'	860'
sand	860'	903'

DEPT. OF NATURAL RESOURCES
BUREAU OF LAND & WATER RESOURCES



FEB 25 1980

RECEIVED

DRILLERS REMARKS:

If well telescopes please sketch and show depths.

GROUND LEVEL

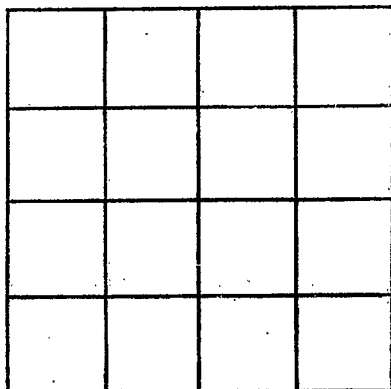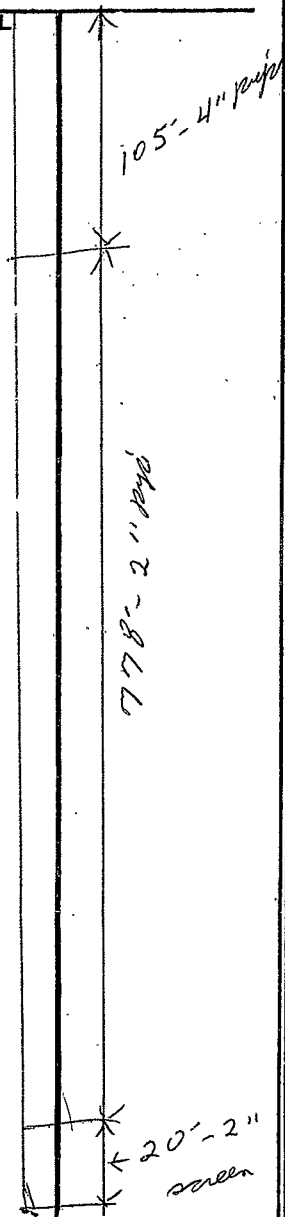

SECTION 29

Please indicate well location X.

ADDITIONAL INFORMATION

A series of horizontal lines for providing additional information.

If more than one screen, show locations of each on sketch.