

MISSISSIPPI DEPARTMENT OF NATURAL RESOURCES

Bureau of Land and Water Resources

Southport Mall

P.O. Box 10631

Jackson, Mississippi 39209

WATER WELL DRILLERS LOG

SHARKEY
A 2002

Feb 21 1985
date well completed

Larry's well & pump
firm name

SHARKEY
county well located

LANDOWNER: H. V. Phelps

description of formations encountered

from

to

Nitta Yuma, Ms.
(mailing address)

SAND

620

740

WELL LOCATION:

sec 30 T 14 S R 6 E
1/4 miles W of Nitta Yuma
(distance) (direction) (nearest town)

WELL PURPOSE:

(home, irrigation, municipal, industrial)

WELL COMPLETION DATA:

- (1) diameter (inches) 4" x 2"
- (2) total depth (feet) 740
- (3) static water level (feet) 20 below above top of ground.
- (4) casing PVC 700
(material) (depth)
4x2 if telescope see back.
(size)
- (5) screen 40 700 to 740
(length) (depth to top)
2" PVC
(size) (material)
- (6) pump 1 20
(HP) (yield gpm)
220 Ohms
(type power)
- (7) electric log NO
(yes or no)

(organization running log)

(8) how well bottom plugged shrink

DRILLERS REMARKS:

RECEIVED
NOV 12 1986

Department of Natural Resources
Bureau of Land & Water Resources


If well telescopes please sketch and show depths.

GROUND LEVEL

120' 4" PVC

580' 2" PVC

40' 2" PVC

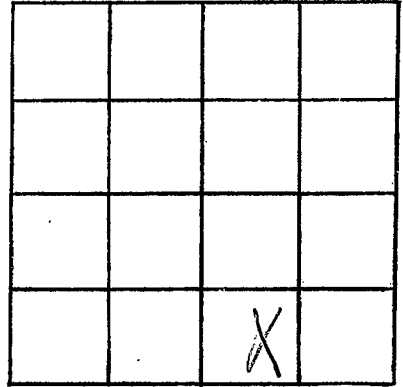

SECTION 30

Please indicate well location X.

ADDITIONAL INFORMATION

If more than one screen, show locations of each on sketch.