

**MISSISSIPPI DEPARTMENT OF NATURAL RESOURCES**  
Bureau of Land and Water Resources

P.O. Box 10631

Jackson, Mississippi 39209

**WATER WELL DRILLERS LOG**

COUNTY WELL LOCATED <i>Sharky</i>		
WELL NUMBER <i>A</i>	CODED	PERMIT NUMBER
DATE WELL COMPLETED <i>2003</i> <i>5-9-90</i>		NAME OF DRILLING FIRM <i>Dyn Well</i>

NAME & MAILING ADDRESS OF LANDOWNER <i>Prudential</i>		
<i>Suite 300 855 Ridgeway Blvd</i>		
<i>Memphis Tenn. 38119</i>		
WELL LOCATION: #SEC	TOWNSHIP	RANGE
<i>35</i>	<i>14</i> <sup>(N)</sup>	<i>6</i> <sup>(E)</sup>
DISTANCE	DIRECTION	NEAREST TOWN
_____ Miles	_____ of _____	_____
OTHER LANDMARK		
WELL PURPOSE: Home, <u>Irrigation</u> , Municipal, Industrial, Fish Pond, etc.		

<b>PUMP DATA</b>		
PUMP TYPE (Circle One): Submersible, <u>Turbine</u> , Jet, Flowing Well, Other (Describe) _____		
POWER TYPE (Circle One): Electric, Tractor, <u>Diesel</u> , Gasoline, Butane, Other (Describe) _____ H/P _____		
Pump Capacity (GPM) <i>3000</i>	No. of Stages <i>1</i>	Setting Depth <i>60</i> FT.
PUMP TEST		
Well yielded _____ GPM with a drawdown of _____ ft. after _____ hours of pumping		

<b>WELL DATA</b>		
Well Depth <i>114'</i>	Casing Diameter (In.) <i>16"</i>	Casing Length (Ft.) <i>74'</i>
Type of Casing <i>steel</i>	Hole Depth	Depth to Static Water Level
TYPE OF COMPLETION: (Circle One or More): <u>Gravel Packed</u> , Underreamed, Telescoped, Natural Development, Open Hole, Other (Describe) _____		
Top of Lap Pipe or Reduction in Casing		
FEET	IF TELESCOPED OR MORE THAN ONE SCREEN: USE BACK PAGE	

<b>LOG DATA</b>	
TYPE OF LOG RUN (Circle One): Electric, Gamma Ray, Density, Sonic, Neutron, Other (Describe) _____ <u>No Log Run</u>	
Name of Organization Running Log <i>None</i>	

<b>SCREEN DATA</b>		
Diameter - Inches <i>16"</i>	Length - Feet <i>40'</i>	Slot Size - Inches <i>.030</i>
Screen Type <i>Wire Wrap</i>	Depth to Bottom - Feet	

<b>GEOLOGIC DATA (Office Use Only)</b>			
Surface Elev.	Geologic Unit	Unit Thickness	Depth to Top
Subs. SWL	Date	Analysis	Aquifer Test


Driller's Remarks

DESCRIPTION OF FORMATIONS ENCOUNTERED	FROM	TO
<i>Clay</i>	<i>0</i>	<i>28</i>
<i>Fine Sand</i>	<i>28</i>	<i>40</i>
<i>Fine Sand + Gravel</i>	<i>40</i>	<i>55</i>
<i>M Sand + Gravel</i>	<i>55</i>	<i>78</i>
<i>Clay</i>	<i>78</i>	<i>86</i>
<i>Fine Sand + Clay</i>	<i>86</i>	<i>90</i>
<i>M Sand + Gravel</i>	<i>90</i>	<i>114</i>

FORMATIONS (Continued)	FROM	TO
<b>RECEIVED</b>		
<b>JUN 29 1990</b>		
Department of Natural Resources Bureau of Land & Water Resources		
IF MORE SPACE IS NEEDED, USE BACK		

If well telescopes please  
sketch and show depths.

GROUND LEVEL

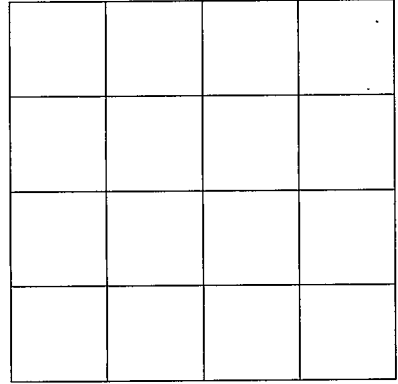

SECTION \_\_\_\_\_

Please indicate well location X.

ADDITIONAL INFORMATION

If more than one screen,  
show location of each on sketch.