

MISSISSIPPI DEPARTMENT OF ENVIRONMENTAL QUALITY

Office of Land and Water Resources

P. O. Box 10631
Jackson, MS 39289-0631
WATER WELL DRILLERS LOG

COUNTY WELL LOCATED
Sharkey

WELL NUMBER A CODED 2005

DATE WELL COMPLETED
7-23-96

PERMIT NUMBER _____

NAME OF DRILLING FIRM
Schudco Ltd

NAME & MAILING ADDRESS OF LANDOWNER
Bill Skates 2mo Partnership
P.O. Box 63
Quon Mo 38723

WELL LOCATION: SEC _____ TOWNSHIP 10 14 RANGE 6

DISTANCE _____ DIRECTION NW NEAREST TOWN Delta City

OTHER LANDMARK _____

WELL PURPOSE: Home Irrigation Municipal, Industrial, Fish Pond, etc.

PUMP DATA

PUMP TYPE (Circle One):
 Submersible, Turbine, Jet, Flowing Well,
Other (Describe) _____

POWER TYPE (Circle One):
 Electric, Tractor, Diesel, Gasoline, Butane,
Other (Describe) _____ H/P 0

Pump Capacity (GPM) 1200 No. of Stages 1 Setting Depth 70 FT.

PUMP TEST

Well yielded _____ GPM with
a drawdown of _____ ft.
after _____ hours of pumping

WELL DATA

Well Depth <u>85</u>	Casing Diameter (In.) <u>10</u>	Casing Length (Ft.) <u>85</u>
Type of Casing <u>pvc</u>	Hole Depth <u>100</u>	Depth to Static Water Level _____

LOG DATA

TYPE OF LOG RUN (Circle One):
 No Log Run
Electric, Gamma Ray, Density, Sonic, Neutron,
Other (Describe) _____

Name of Organization Running Log _____

TYPE OF COMPLETION: (Circle One or More):
 Gravel Packed, Underreamed, Telescoped,
Natural Development, Open Hole, Other
(Describe) _____

WELL GROUTED TO A DEPTH OF 10 FEET
Type Grout (circle one): Cement, Bentonite, Or Mix

GEOLOGIC DATA (Office Use Only)

Surface Elev.	Geologic Unit	Unit Thickness	Depth to Top
Subs. SWL	Date	Analysis	Aquifer Test

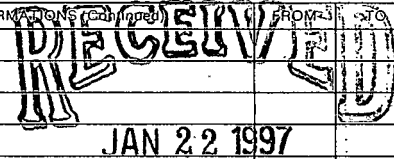
Driller's Remarks _____

Top of Lap Pipe or Reduction in Casing _____

FEET IF TELESCOPED OR MORE THAN ONE SCREEN: USE BACK PAGE

SCREEN DATA

Diameter - Inches <u>10</u>	Length - Feet <u>20</u>	Slot Size - Inches <u>.032</u>
Screen Type <u>pvc</u>	Depth to Bottom - Feet <u>85</u>	

DESCRIPTION OF FORMATIONS ENCOUNTERED	FROM	TO	FORMATIONS (continued)
<u>clay & Gumbo</u>	<u>0</u>	<u>62</u>	
<u>C-sand & gravel</u>	<u>62</u>	<u>85</u>	
<u>clay</u>	<u>85</u>	<u>87</u>	
<u>fine sand</u>	<u>87</u>	<u>100</u>	

Dept. of Environmental Quality
Office of Land & Water Resources

IF MORE SPACE IS NEEDED, USE BACK

If well telescopes please
sketch and show depths.

GROUND LEVEL

	X		

SECTION 10

Please indicate well location X.

ADDITIONAL INFORMATION

If more than one screen,
show location of each on sketch.