

Sharkey
B

MISSISSIPPI DEPARTMENT OF NATURAL RESOURCES
Bureau of Land and Water Resources
Southport Mall
P.O. Box 10631
Jackson, Mississippi 39209
WATER WELL DRILLERS LOG

14

Sharkey
Washington

11-17 1981 date well completed
Dyer Well + Irrigation firm name
Humphrey county well located

LANDOWNER: David Greer
Rt. 2 Box 22
Hollandale, Ms.
(mailing address)

description of formations encountered	from	to
<u>Clay</u>	<u>0</u>	<u>30</u>
<u>Fine Sand</u>	<u>36</u>	<u>68</u>
<u>Sand + Gravel</u>	<u>68</u>	<u>123</u>

WELL LOCATION:
sec. 4 T. 14 N. R. 5 E.
S. W.
5 miles NE of Delta City
(distance) (direction) (nearest town)

WELL PURPOSE: Irrigation
(home, irrigation, municipal, industrial)

- WELL COMPLETION DATA:
- (1) diameter (inches) 16"
 - (2) total depth (feet) 123
 - (3) static water level (feet) 18 below above top of ground.
 - (4) casing Steel (material), (depth)
16' if telescope see back. (size)
 - (5) screen 40' (length), (depth to top)
16, Mild Steel (size), (material)
 - (6) pump 400 2000 (HP), (yield gpm)
Vertical (type power)
 - (7) electric log No (yes or no)
(organization running log)
 - (8) how well bottom plugged Plate

DRILLERS REMARKS:


DEPT. OF NATURAL RESOURCES
BUREAU OF LAND & WATER RESOURCES

MAY 19 1982

RECEIVED

If well telescopes please sketch and show depths.

GROUND LEVEL

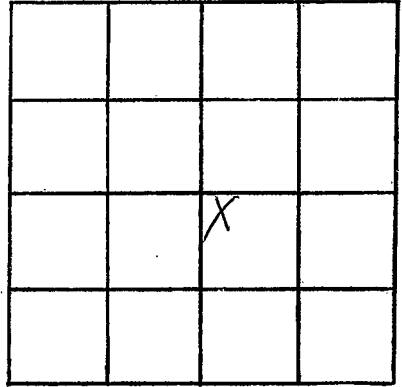

SECTION 4

Please indicate well location X.

ADDITIONAL INFORMATION

If more than one screen,
show locations of each on sketch.