

SHARKEY
B5
5-9-71

MISSISSIPPI
 BOARD OF WATER COMMISSIONERS
 416 North State Street
 Jackson, Mississippi 39201

CODED

WATER WELL DRILLERS LOG

MAY 4 1971 E.M. "Bud" Cresswell SHARKEY
 date well completed firm name county well located

LANDOWNER:

description of formations encountered

from

to

J. H. Mouchett

Louise, Miss-
 (mailing address)

Clay	0	20
sand. gravel	20	170
gravel	170	230
sand	230	320
shells	320	440
sand	440	560

WELL LOCATION:

sec. 32 T. 14 R. 5 E
1 miles West of Bayou
 (distance) (direction) (nearest town)

WELL PURPOSE: Domestic
 (home, irrigation, municipal, industrial)

WELL COMPLETION DATA:

- (1) diameter (inches) 2 X 4
- (2) total depth (feet) 560
- (3) static water level (feet) 12 below above top of ground.
- (4) casing Steel, 189
 (material) (depth)
4"
 (size) if telescope see back.
- (5) screen 20ft., 540
 (length) (depth to top)
2", Stainless
 (size) (material)
- (6) pump 1, 20
 (HP) (yield gpm)
0
 (type power)
- (7) electric log No
 (yes or no)
0
 (organization running log)

CODED

(8) how well bottom plugged Steel plug


MAY 20 1971

DRILLERS REMARKS:

MISS. Bd. of
 WATER COMM.

If well telescopes please sketch and show depths.

GROUND LEVEL

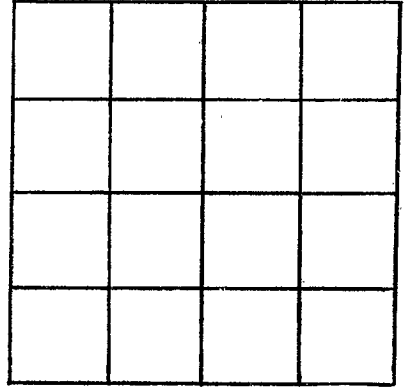

SECTION _____

Please indicate well location X.

ADDITIONAL INFORMATION

If more than one screen,
show locations of each on sketch.