

**SHARKEY**  
**B8**  
**6-23-72**

MISSISSIPPI  
 BOARD OF WATER COMMISSIONERS  
 416 North State Street  
 Jackson, Mississippi 39201

**CODED**

WATER WELL DRILLERS LOG

6-23 1972 Bailey Drilling Co. Sharkey  
 date well completed firm name county well located

LANDOWNER: A B Williams  
Delta City, Miss.  
 (mailing address)

description of formations encountered	from	to
	<u>Clay</u>	<u>0</u>
<u>Sand</u>	<u>20</u>	<u>70</u>
<u>Gravel</u>	<u>70</u>	<u>155</u>
<u>Mud</u>	<u>155</u>	<u>480</u>
<u>Sand</u>	<u>480</u>	<u>606</u>

WELL LOCATION:  
 sec. 19 T. 14 N. R. 5 E  
 (distance) (direction) (nearest town)  
4 miles E of Delta City

WELL PURPOSE: Farm  
 (home, irrigation, municipal, industrial)

- WELL COMPLETION DATA:
- (1) diameter (inches) 4 X 2
  - (2) total depth (feet) 606
  - (3) static water level (feet) 15 below top of ground.
  - (4) casing Steel, 588,  
 (material) (depth)  
4 X 2 if telescope see back.  
 (size)
  - (5) screen 18', 588  
 (length) (depth to top)  
2", Stainless Steel  
 (size) (material)
  - (6) pump 1/2, 25  
 (HP) (yield gpm)  
Electric  
 (type power)
  - (7) electric log No.  
 (yes or no)

**CODED**

JUN 20 1972

MISS. ED. DEPT.  
 WATER DIVISION

(organization running log)

(8) how well bottom plugged  
Back pressure valve

DRILLERS REMARKS:


If well telescopes please sketch and show depths.

GROUND LEVEL

126' 4"

462' 2"

18 ft 3/4" screen

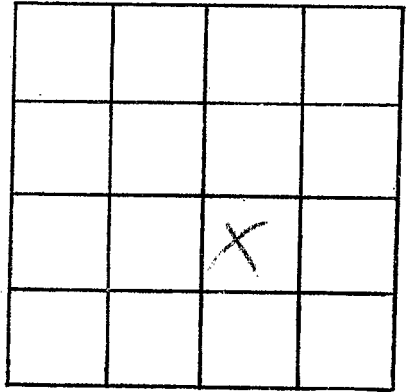

SECTION 19

Please indicate well location X.

ADDITIONAL INFORMATION

If more than one screen, show locations of each on sketch.