

SHARKEY
B 9
2-12-74

MISSISSIPPI
BOARD OF WATER COMMISSIONERS
416 North State Street
Jackson, Mississippi 39201

CODED

WATER WELL DRILLERS LOG

SHARKEY

2-12-1974 date well completed 1974 DYER WELL & IRRIGATION SERVICE firm name MISSISSIPPI county well located

LANDOWNER: Roy Johnson

description of formations encountered

from to

BELZONI,

CLAY

0 64

CLAY & GRAVEL

64 73

MISS.

SAND & GRAVEL

73 118

(mailing address)

PK 12

118

WELL LOCATION:

sec. 11 T. 14 N. R. 5 E.
8 miles WEST of MIDNITE
(distance) (direction) (nearest town)

WELL PURPOSE: IRR.
(home, irrigation, municipal, industrial)

WELL COMPLETION DATA:

- (1) diameter (inches) 16"
- (2) total depth (feet) 208'
- (3) static water level (feet) 7' below top of ground.
- (4) casing PUEB. 78' (material) (depth)
16" (size) if telescope see back.
- (5) screen 40' 78' (length) (depth to top)
16" BURINGOT (size) (material)
- (6) pump 100 3000 (HP) (yield gpm)
Diesel (type power)
- (7) electric log NO (yes or no)

CODED

(organization running log)

(8) how well bottom plugged P. PLATE


DRILLERS REMARKS:

REGISTERED

FEB 14 1974

If well telescopes please sketch and show depths.

GROUND LEVEL

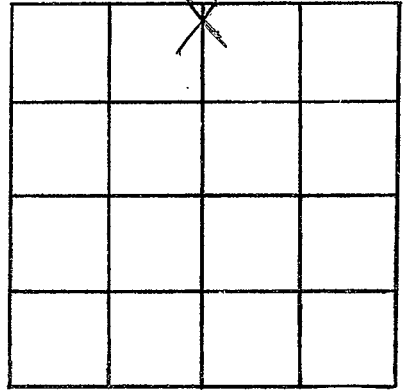

SECTION 11

Please indicate well location X.

ADDITIONAL INFORMATION

If more than one screen, show locations of each on sketch.