

**SHARKEY**  
**B III**  
**7-17-74**

MISSISSIPPI  
 BOARD OF WATER COMMISSIONERS CODED  
 416 North State Street  
 Jackson, Mississippi 39201

WATER WELL DRILLERS LOG

7-17 1974 OWENS p/bg. Sharkey  
 date well completed firm name county well located

LANDOWNER: BRAD FORD  
WOODS Rt. 1, Box 243  
Rolling Fork, MS.  
 (mailing address)

description of formations encountered	from	to
top soil	0	21
Clay	21	60
Sand & gravel	60	144
Red clay mixed	144	249
Sand	249	400

WELL LOCATION:  
 sec 29 T 14 R 5  
 S N E W  
 (distance) (direction) (nearest town)

WELL PURPOSE: HOME  
 (home, irrigation, municipal, industrial)

WELL COMPLETION DATA:

(1) diameter (inches) 2"

(2) total depth (feet) 400'

(3) static water level (feet) 16' below top of ground.

(4) casing Galv. 390'  
 (material) (depth)

(size) if telescope see back.

(5) screen 10' 400'  
 (length) (depth to top)

2" S.S.G.  
 (size) (material)

(6) pump 1 23  
 (HP) (yield gpm)


Elec.  
 (type power)

(7) electric log NO  
 (yes or no)

(organization running log)


(8) how well bottom plugged S.B

DRILLERS REMARKS: OWENS

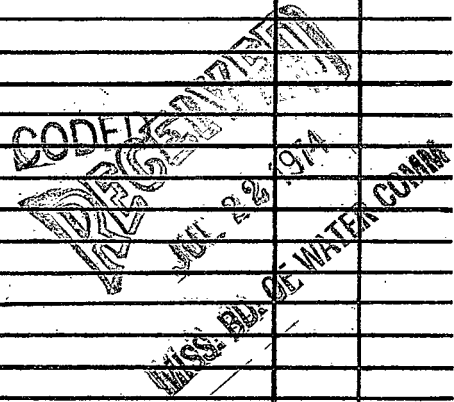

If well telescopes please sketch and show depths.

GROUND LEVEL

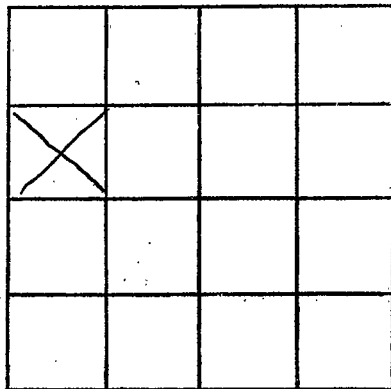

SECTION \_\_\_\_\_

Please indicate well location X.

ADDITIONAL INFORMATION

If more than one screen, show locations of each on sketch.