

Sharkey

MISSISSIPPI BOARD OF WATER COMMISSIONERS

B12

8-66

WATER WELL DRILLERS LOG CODED Sharkey

Date: 8-22, 1966, Driller: Butane Gas Co. County: Jefferson

(Name)

(1) Owner of Land: A.B. Williams
(Name)
Delta City, Miss.
(Address)

(2) Location: NE 1/4, SW 1/4, Sec. 19 T4R5W
3 miles SE of Delta City.
(distance) (direction) (Nearest Town)

(3) Topography: Flat
(Hilly) (Flat) (Level)

(4) Purpose of Well: Irrigation
(Domestic Irrigation, Municipal, Industrial, Other)

Description & Color of Materials Sand, Clay, Red Clay, Shell, etc.	Thick- ness Feet	Depth Feet
Clay	13	13
Clay	10	23
Fine Sand	10	33
" "	10	43
" "	10	53
Med. Sand	10	63
Coarse Sand - Gravel	10	73
CODED " "	10	83
" " "	10	93
" " "	10	103

Information upon completion of well:

(1) Diameter 16 inches.

(2) Total Depth 103 feet.

(3) Water Level 20 feet below top of ground.

(4) Cased to 63, Size 16


(5) Screen: Size 16, Length 40

(6) Were any formations sealed against pollution?
yes, X no.

If YES depth of formation

Why

Drillers Remarks:

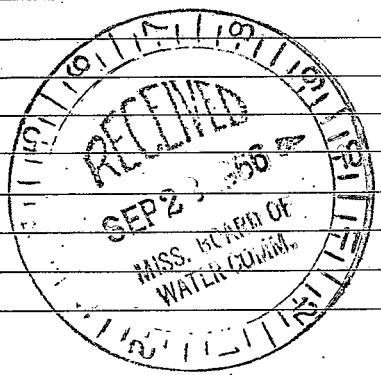

(Use Back Side)

Well No.

