

Sharkey

B13

4-67

GW 2916

MISSISSIPPI
 BOARD OF WATER COMMISSIONERS
 416 North State Street
 Jackson, Mississippi 39201

CODED

WATER WELL DRILLERS LOG

Sharkey

4/25/1967 date well completed
 Dyer Well & Irrigation firm name
 Washington county well located

LANDOWNER: F. W. Clinkscales

R. R. Hollandale,

Mississippi

(mailing address)

WELL LOCATION:

sec. 20 T. 14 N. R. 5 E.
 S. 5 W.
 4 miles S. E. of Delta
 (distance) (direction) (nearest town)

WELL PURPOSE: IRRIGATION
 (home, irrigation, municipal, industrial)

WELL COMPLETION DATA:

- (1) diameter (inches) 16"
- (2) total depth (feet) 113 Ft.
- (3) static water level (feet) 20 Ft. below top of ground.
- (4) casing 16, 73 Ft., Blk. Iron (material) (depth)
- (size) if telescope see back.
- (5) screen 40 Ft., 73 Ft. (length) (depth to top)
- 16" Blk. Iron (Doerr) (size) (material)
- (6) pump 50 3,000 (HP) (yield gpm)
- Diesel (type power)
- (7) electric log No (yes or no)
- (organization running log)

(8) how well bottom plugged
 Plate Welded on bottom

DRILLERS REMARKS:


None

description of formations encountered

from to


Clay	0	13
Clay	13	23
Clay	23	33
Fine Sand	33	43
Fine Sand	43	53
Fine Sand	53	63
Coarse Sand	63	73
Coarse sand	73	83
Coarse sand & gravel	83	93
" " " " "	93	103
" " " " "	103	113

CODED

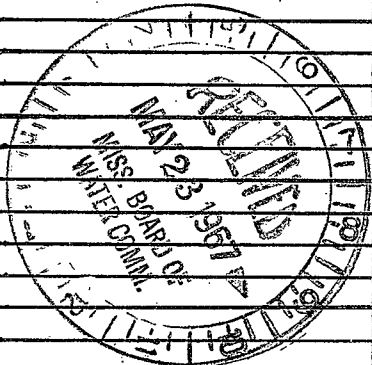

If well telescopes please sketch and show depths.

GROUND LEVEL

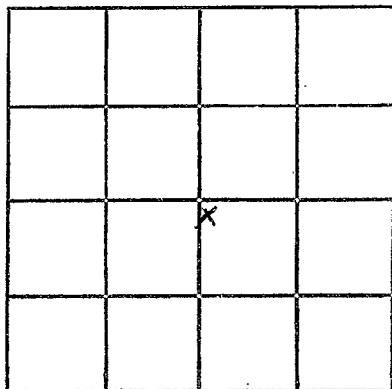

SECTION 70

Please indicate well location X.

ADDITIONAL INFORMATION

If more than one screen, show locations of each on sketch.