

Shurkey  
B14  
6-68

MISSISSIPPI  
BOARD OF WATER COMMISSIONERS  
416 North State Street  
Jackson, Mississippi 39201

**CODED**

WATER WELL DRILLERS LOG

6-1 1968 DYER WELLS INC. SHURKEY  
date well completed firm name county well located

LANDOWNER:

W. E. Patterson Jr.

description of formations encountered

from to

Delta City, Miss  
(mailing address)

CLAY	0	18
FINE SAND	18	23
MED. SAND	23	53
W L	53	58
COARSE GRAVEL	58	73
HARD FINE SAND	73	83
SAND & GRAVEL	83	103

WELL LOCATION:

sec 30 T. 14 N R 5 E  
S W

(distance) miles (direction) of (nearest town)

WELL PURPOSE: IRRIGATION  
(home, irrigation, municipal, industrial)

WELL COMPLETION DATA:

(1) diameter (inches) 16"

(2) total depth (feet) 100'

(3) static water level (feet) 21' below top of ground.

(4) casing B.I. 60'  
(material) (depth)

16" if telescope see back.  
(size)

(5) screen 40' 60'  
(length) (depth to top)

16" Bea Ingot  
(size) (material)

(6) pump 60 3000  
(HP) (yield gpm)

Dieser  
(type power)

(7) electric log No  
(yes or no)

(organization running log)

(8) how well bottom plugged RATE


**CODED**  
BOTTOM  
100'

JUL 2 - 1968  
MISS. BOARD OF  
WATER COMM.

DRILLERS REMARKS:

If well telescopes please sketch and show depths.

GROUND LEVEL

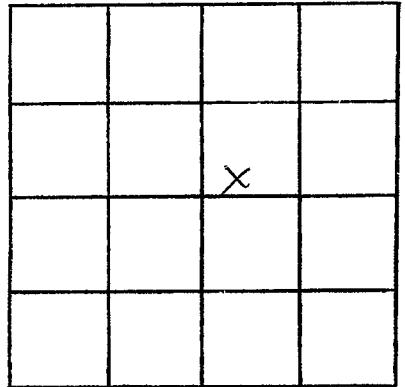

SECTION 30

Please indicate well location X.

ADDITIONAL INFORMATION

If more than one screen, show locations of each on sketch.