

SHARKEY  
B19  
7-3-77

MISSISSIPPI  
BOARD OF WATER COMMISSIONERS  
416 North State Street  
Jackson, Mississippi 39201

CODED

WATER WELL DRILLERS LOG

7-3 1977 Dyer Well + Irrigation Sharkey  
date well completed firm name county well located

LANDOWNER: W.A. Hadnett  
Route 1  
Anquille, Miss.  
(mailing address)

description of formations encountered	from	to
Clay	0	33
Fine Sand	33	42
SAND + GRAVEL	42	113

WELL LOCATION:  
sec. 25 T. 14 N. R. 5 E  
S W  
7 miles NW of Lumberton  
(distance) (direction) (nearest town)

WELL PURPOSE: Irrigation  
(home, irrigation, municipal, industrial)

- WELL COMPLETION DATA:
- (1) diameter (inches) 16"
  - (2) total depth (feet) 113'
  - (3) static water level (feet) 35' below top of ground.
  - (4) casing Steel 73' (material), (depth)  
12" (size) if telescope see back.
  - (5) screen 40' 73' (length), (depth to top)  
16" Steel (size), (material)
  - (6) pump 100 2000 (HP), (yield gpm)  
Diesel (type power)
  - (7) electric log No (yes or no)
  - (organization running log)
  - (8) how well bottom plugged Plate

DRILLERS REMARKS:

MISSISSIPPI BOARD OF WATER COMMISSIONERS

SEP 20 1977

MISSISSIPPI BOARD OF WATER COMMISSIONERS

If well telescopes please  
sketch and show depths.


GROUND LEVEL

16"  
Casing

73'

40'  
Screen  
2 Sections

73-123'

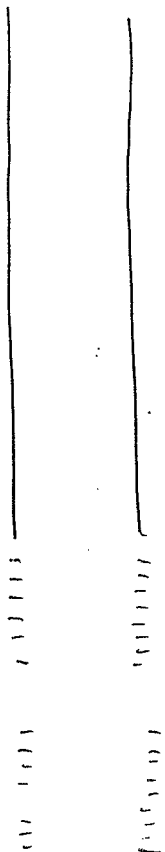

	X		

SECTION 25

Please indicate well location X.

ADDITIONAL INFORMATION

Blank lined area for additional information.

If more than one screen,  
show locations of each on sketch.