

SHARKEY
B 210
11-12-68

MISSISSIPPI
 BOARD OF WATER COMMISSIONERS
 416 North State Street
 Jackson, Mississippi 39201

CODED
CODED
CODED

WATER WELL DRILLERS LOG

11/12 1968 Bailey Drilling Co. Sharkey
 date well completed firm name county well located

LANDOWNER: James C. Boykin
Delta City, Miss.
 (mailing address)

description of formations encountered	from	to
<u>Clay</u>	<u>0</u>	<u>30</u>
<u>Sand</u>	<u>30</u>	<u>90</u>
<u>Gravel</u>	<u>90</u>	<u>110</u>
<u>Mud</u>	<u>110</u>	<u>230</u>
<u>Sand + Mud</u>	<u>230</u>	<u>480</u>
<u>Mud</u>	<u>480</u>	<u>520</u>
<u>Sand</u>	<u>520</u>	<u>604</u>

WELL LOCATION:
 sec. 19 T. 14 N R. 5 E
3 miles S of Delta City
 (distance) (direction) (nearest town)

WELL PURPOSE: Farm
 (home, irrigation, municipal, industrial)

WELL COMPLETION DATA:


- (1) diameter (inches) 4 X 2
- (2) total depth (feet) 604
- (3) static water level (feet) 8 below top of ground.
- (4) casing Steel (material) (depth)
- 4 X 2 (size) if telescope see back.
- (5) screen 16 (length) 588 (depth to top)
- 2" (size) Stainless Steel (material)
- (6) pump 1 (HP) 20 (yield gpm)
- Elec (type power)
- (7) electric log No (yes or no)
- (organization running log)
- (8) how well bottom plugged Back pressure valve

CODED

CODED

CODED

CODED

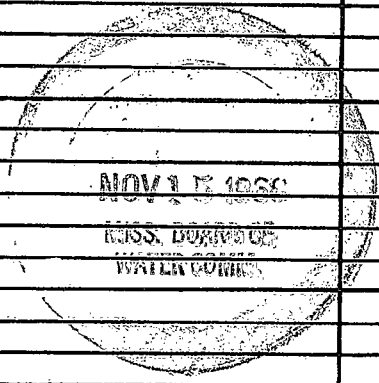

DRILLERS REMARKS:

If well telescopes please sketch and show depths.

GROUND LEVEL

1 67' 11"

1000'

11825'

164' 2' Trainer

		X	

SECTION 19

Please indicate well location X.

ADDITIONAL INFORMATION

If more than one screen, show locations of each on sketch.