

Sharkey
B 22
3-28-70

MISSISSIPPI
BOARD OF WATER COMMISSIONERS
416 North State Street
Jackson, Mississippi 39201

CODED

WATER WELL DRILLERS LOG

3-28-70 19 DYER WELL & IRRIGATION SERVICE SHARKEY
date well completed firm name county well located

LANDOWNER:	description of formations encountered	from	to
W. E. Patterson, JR.	Clay	0	33
Delta City Miss.	Fine Sand	33	43
(mailing address)	COARSE BROWN Sand	43	53
	Sand & GRAVEL	53	113
WELL LOCATION:			
sec. 31 T-14N R-5E			
5 miles SE of Delta City			
(distance) (direction) (nearest town)			
WELL PURPOSE: FRR.			
(home, irrigation, municipal, industrial)			
WELL COMPLETION DATA:			
(1) diameter (inches) 16"			
(2) total depth (feet) 113			
(3) static water level (feet) 17 below above top of ground.			
(4) casing Steel 73			
(material) (depth)			
16" If telescope see back.			
(size)			
(5) screen 40' 73'			
(length) (depth to top)			
16" Steel			
(size) (material)			
(6) pump 50 2500			
(HP) (yield gpm)			
Diesel			
(type power)			
(7) electric log No			
(yes or no)			
(organization running log)			
(8) how well bottom plugged Plate			
DRILLERS REMARKS:			


CODED

APR - 1 1970

MISS. BD. OF
WATER COMM.

If well telescopes please sketch and show depths.

GROUND LEVEL

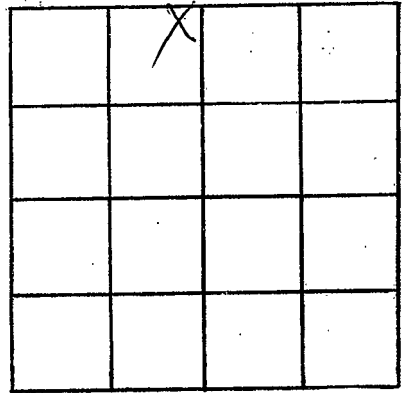

SECTION 31

Please indicate well location X.

ADDITIONAL INFORMATION

If more than one screen,
show locations of each on sketch.