

SHARKEY
B. 23
1-26-71

MISSISSIPPI
 BOARD OF WATER COMMISSIONERS
 416 North State Street
 Jackson, Mississippi 39201

CODED

WATER WELL DRILLERS LOG

1-26-71 date well completed 19 DAVID BERRY firm name Sharkey county well located

LANDOWNER: <u>Joseph H. Pearce</u>	description of formations encountered	from	to
<u>Pt. 1</u>			
<u>Anguilla Miss 38721</u> (mailing address)	<u>top gravel</u>	<u>0</u>	<u>35</u>
	<u>SAND & GRAVEL</u>	<u>35</u>	<u>66</u>
	<u>Gravel</u>	<u>66</u>	<u>159</u>
	<u>Oolite</u>	<u>159</u>	<u>244</u>
	<u>Gravel</u>	<u>244</u>	<u>305</u>
	<u>Shale</u>	<u>305</u>	<u>337</u>
	<u>SHALE WITH SAND</u>	<u>337</u>	<u>430</u>
	<u>SAND - FINE</u>	<u>430</u>	<u>461</u>
	<u>SAND - FAIR</u>	<u>461</u>	<u>554</u>
	<u>SAND - GOOD</u>	<u>554</u>	<u>618</u>
WELL LOCATION:			
sec. <u>27</u> T. <u>14</u> N. R. <u>5</u> E. <u>W</u>			
<u>1 1/2</u> miles <u>SW</u> of <u>Sharkey</u>			
(distance) (direction) (nearest town)			
WELL PURPOSE:			
(home, irrigation, municipal, industrial)			
WELL COMPLETION DATA:			
(1) diameter (inches) <u>4 X 2</u>			
(2) total depth (feet) <u>618 ft.</u>			
(3) static water level (feet) <u>5</u> below top of ground.			
(4) casing <u>A.P.I. BLACK</u> <u>583</u> (material) (depth) <u>100' x 4"</u> <u>453' x 2 1/2"</u> if telescope see back. (size)			
(5) screen <u>30 ft.</u> <u>583 ft.</u> (length) (depth to top) <u>2" #06 Stainless</u> (size) (material)			
(6) pump <u>1</u> (HP) (yield gpm) <u>acc.</u> (type power)			
(7) electric log <u>no</u> (yes or no)			
(organization running log)			
(8) how well bottom plugged <u>18" x 1 1/2"</u> <u>plug</u>			
DRILLERS REMARKS:			

CODED

MAR 21 1971

MISS. SD. OF
 WATER COMMISSIONERS


If well: telescopes please sketch and show depths.

GROUND LEVEL

10' of
4"

453' of
2"

30' of
2" screen

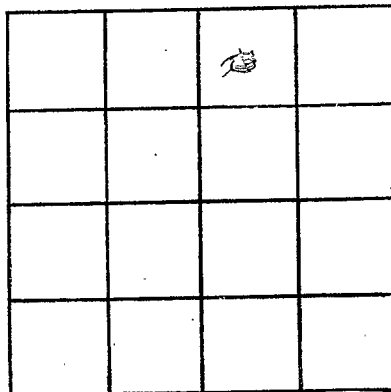

SECTION 27

Please indicate well location X.

ADDITIONAL INFORMATION

If more than one screen, show locations of each on sketch.