

SHARKEY
B 25
1-26-71

MISSISSIPPI
 BOARD OF WATER COMMISSIONERS
 416 North State Street
 Jackson, Mississippi 39201

CODED

WATER WELL DRILLERS LOG

1/26/71 19 DYER WELL & IRRIGATION SERVICE SHARKEY
 date well completed firm name county well located

LANDOWNER:
W. E. PATTERSON JR.
DELTA CITY, MISS
 (mailing address)

| description of formations encountered | from | to |
|---------------------------------------|------|-----|
| CLAY | 0 | 15 |
| SAND | 15 | 170 |
| SAND + CLAY | 170 | 250 |
| CLAY | 250 | 320 |
| SAND + CLAY | 320 | 470 |
| SAND | 470 | 602 |

WELL LOCATION:
 sec 29 T 14 N R 5 W SHARKEY
 (distance) miles (direction) of (nearest town)

WELL PURPOSE: Home
 (home, irrigation, municipal, industrial)

WELL COMPLETION DATA:

(1) diameter (inches) 4" x 2"

(2) total depth (feet) 587

(3) static water level (feet) 7 below above top of ground.

(4) casing 2" GALV 567'
 (material) (depth)
4" x 2" if telescope see back.
 (size)

(5) screen 20' 567'
 (length) (depth to top)
2" STAINLESS STEEL
 (size) (material)

(6) pump 1 30
 (HP) (yield gpm)
Electric
 (type power)

(7) electric log No
 (yes or no)

(organization running log)

CODED

(8) how well bottom plugged BACK
WASH VALVE


MAR 22 1971

DRILLERS REMARKS:

MISS. BD. OF
 WATER

If well telescopes please sketch and show depths.

GROUND LEVEL

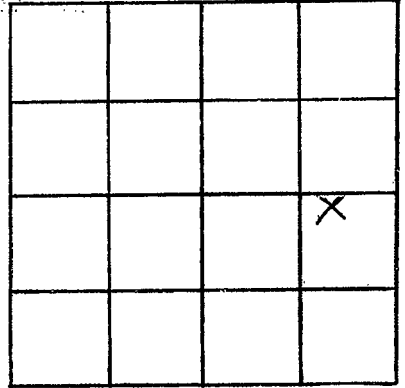

SECTION 29

Please indicate well location X.

ADDITIONAL INFORMATION

If more than one screen,
show locations of each on sketch.