

SHARKEY
B26
7-23-79

MISSISSIPPI
 BOARD OF WATER COMMISSIONERS
 416 North State Street
 Jackson, Mississippi 39201

CODED

WATER WELL DRILLERS LOG

7-23-- 1979 Larry's Well Pump Co - Sharkey
 date well completed firm name county well located

LANDOWNER: Willie Duddy
Anguilla miss
 (mailing address)

WELL LOCATION:
 sec 14 T N R 5 E
2 North miles 6 West of midnight
 (distance) (direction) (nearest town)

WELL PURPOSE:
 (home, irrigation, municipal, industrial)

WELL COMPLETION DATA:

(1) diameter (inches) 4" x 2"
 (2) total depth (feet) 670
 (3) static water level (feet) 20 ^{below} 100 ^{above} 650
 top of ground. 4-100 - 2 = 650
 (4) casing steel 650
 (material) (depth)
 (size) If telescope see back.
 (5) screen 20 650
 (length) (depth to top)
 (size) steel
 (material)
 (6) pump 1 20
 (HP) (yield gpm)
Electric
 (type power)
 (7) electric log _____
 (yes or no)
 (organization running log)
 (8) how well bottom plugged steel plate

description of formations encountered	from	to
<u>clay</u>	<u>0</u>	<u>15</u>
<u>sand & gravel</u>	<u>15</u>	<u>170</u>
<u>clay</u>	<u>170</u>	<u>200</u>
<u>clay with sand</u>	<u>200</u>	<u>420</u>
<u>clay</u>	<u>420</u>	<u>620</u>
<u>sand</u>	<u>620</u>	<u>670</u>

CODED

Misc. Board of Water Comm.


AUG 21 1979

RECEIVED

DRILLERS REMARKS:

If well telescopes please
sketch and show depths.

GROUND LEVEL

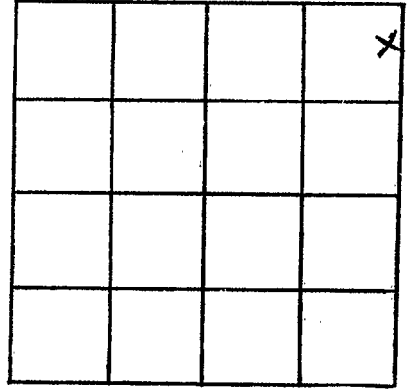

SECTION 2

Please indicate well location X.

ADDITIONAL INFORMATION

If more than one screen,
show locations of each on sketch.