

MISSISSIPPI DEPARTMENT OF NATURAL RESOURCES

Bureau of Land and Water Resources

Southport Mall

P.O. Box 10631

Jackson, Mississippi 39209

WATER WELL DRILLERS LOG

COPYED

Sharkey
B 31
11/11/80


11/11 1980 date well completed Larry's Well & Pump firm name Sharkey county well located

LANDOWNER:	description of formations encountered	from	to
Huey Boyd	CLAY	0	45
Lowise, MS (mailing address)	FINE SAND	45	55
	COARSE SAND + GRAVEL	55	112

WELL LOCATION:
sec. 12 T 14 N R 5 E W
12 miles NE of Osquillo
(distance) (direction) (nearest town)

WELL PURPOSE: FISH POND
(home, irrigation, municipal, industrial)


- WELL COMPLETION DATA:
- (1) diameter (inches) 16"
 - (2) total depth (feet) 112'
 - (3) static water level (feet) 20 below top of ground.
 - (4) casing Steel 72' (material) (depth)
(size) If telescope see back.
 - (5) screen 40' 72' (length) (depth to top)
16" Steel (size) (material)
 - (6) pump 60 3000 (HP) (yield gpm)
(type power)
 - (7) electric log NO (yes or no)
(organization running log)
 - (8) how well bottom plugged Steel Plate

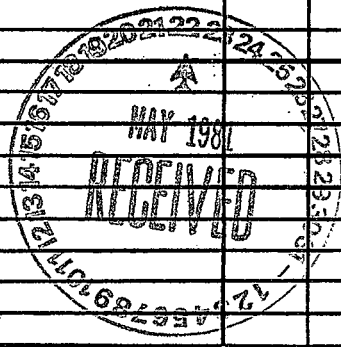

DRILLERS REMARKS:

If well telescopes please
sketch and show depths.

GROUND LEVEL

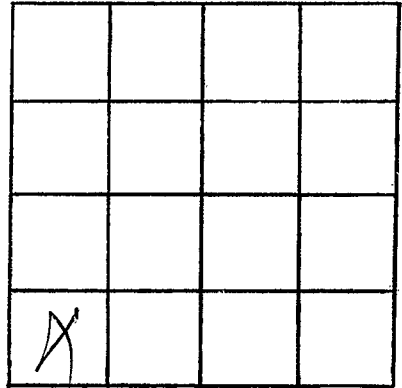

SECTION 12

Please indicate well location X.

ADDITIONAL INFORMATION

If more than one screen,
show locations of each on sketch.