

MISSISSIPPI DEPARTMENT OF NATURAL RESOURCES

Bureau of Land and Water Resources

Southport Mall

P.O. Box 10631

Jackson, Mississippi 39209

WATER WELL DRILLERS LOG

**CODED**

Sharkey  
B 331  
11/05/80

11/05 1980  
date well completed

Larry's Well & Pump  
firm name

Sharkey  
county well located


LANDOWNER: Mike King  
  
Anguilla MS.  
(mailing address)

description of formations encountered	from	to
Clay	0	45
FINE SAND	45	60
COURSE SAND + GRAVEL	60	117

WELL LOCATION:  
S 11 1/2 T 14 N R 5 E W  
1 1/2 miles NE of Anguilla  
(distance) (direction) (nearest town)

WELL PURPOSE: Fish Pond  
(home, irrigation, municipal, industrial)


- WELL COMPLETION DATA:
- (1) diameter (inches) 16"
  - (2) total depth (feet) 117'
  - (3) static water level (feet) 20 below above top of ground.
  - (4) casing Steel 77' (material) (depth)  
If telescope see back. (size)
  - (5) screen 40' 77' (length) (depth to top)  
16" Steel (size) (material)
  - (6) pump 60 3000 (HP) (yield gpm)  
(type power)
  - (7) electric log NO (yes or no)  
(organization running log)
  - (8) how well bottom plugged Steel Plate

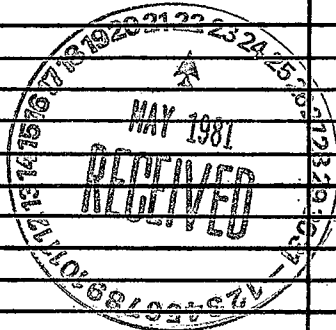

DRILLERS REMARKS:

If well telescopes please sketch and show depths.

GROUND LEVEL

			X

SECTION 12

Please indicate well location X.

ADDITIONAL INFORMATION

If more than one screen,  
show locations of each on sketch.