

MISSISSIPPI DEPARTMENT OF NATURAL RESOURCES

Bureau of Land and Water Resources

Southport Mall

P.O. Box 10631

Jackson, Mississippi 39209

WATER WELL DRILLERS LOG

CODED

Sharkey
B34
12/17/80

12/17 1980 Larry's well & Pump Sharkey
 date well completed firm name county well located


LANDOWNER: <u>George Powell</u>	description of formations encountered	from	to
<u>Anguilla, MS</u> (mailing address)	<u>CLAY</u>	<u>0</u>	<u>35</u>
	<u>FINE SAND</u>	<u>35</u>	<u>45</u>
	<u>MED SAND</u>	<u>45</u>	<u>75</u>
	<u>COURSE SAND</u>	<u>75</u>	<u>116</u>
WELL LOCATION: sec. <u>24</u> T. <u>14</u> N. R. <u>5</u> W. <u>10</u> miles <u>W</u> of <u>Midway</u> (distance) (direction) (nearest town)			
WELL PURPOSE: <u>Fish Pond</u> (home, irrigation, municipal, industrial)			
WELL COMPLETION DATA:			
(1) diameter (inches) <u>16"</u>			
(2) total depth (feet) <u>116'</u>			
(3) static water level (feet) <u>22</u> below above top of ground.			
(4) casing <u>Steel</u> , <u>76'</u> (material) (depth) (size) If telescope see back.			
(5) screen <u>40'</u> , <u>76'</u> (length) (depth to top) <u>16"</u> , <u>Steel</u> (size) (material)			
(6) pump _____ (HP) _____ (yield gpm) (type power)			
(7) electric log <u>NO</u> (yes or no) (organization running log)			
(8) how well bottom plugged <u>Steel Plate</u>			
DRILLERS REMARKS:			

CODED



If well telescopes please sketch and show depths.

GROUND LEVEL

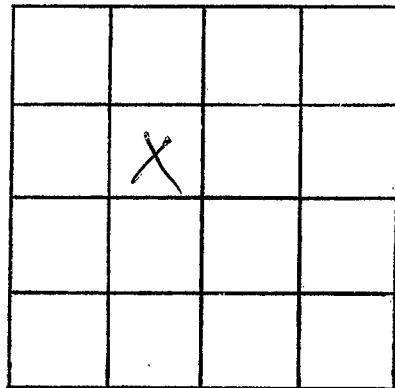

SECTION 24

Please indicate well location X.

ADDITIONAL INFORMATION

If more than one screen,
show locations of each on sketch.