

MISSISSIPPI DEPARTMENT OF NATURAL RESOURCES

Bureau of Land and Water Resources

Southport Mall

P.O. Box 10631

Jackson, Mississippi 39209

WATER WELL DRILLERS LOG

CODED

<i>Sharkey</i>
<b>B 35</b>
6-13-81

June 13, 1981 date well completed      Larry's Well & Pump firm name      Sharkey county well located

LANDOWNER: <u>Mike King</u>	description of formations encountered	from	to
<u>Anguilla MS</u> (mailing address)	<u>Clay</u> <u>fine sand</u> <u>Med. to coarse sand</u>	<u>0</u> <u>31</u> <u>58</u>	<u>36</u> <u>58</u> <u>116</u>
<b>WELL LOCATION:</b> sec. <u>23</u> T <u>14</u> (N) R. <u>5</u> (E) <u>10</u> miles (distance) <u>W</u> (direction) of <u>Madison</u> (nearest town)			
<b>WELL PURPOSE:</b> <u>Fish Pond</u> (home, irrigation, municipal, industrial)			
<b>WELL COMPLETION DATA:</b>			
(1) diameter (inches) <u>12"</u>			
(2) total depth (feet) <u>116'</u>			
(3) static water level (feet) <u>24'</u> <del>above</del> below top of ground.			
(4) casing <u>Steel</u> (material), <u>76'</u> (depth)			
_____ if telescope see back. (size)			
(5) screen <u>40'</u> (length), <u>76'</u> (depth to top)			
<u>12"</u> (size), <u>Steel</u> (material)			
(6) pump _____ (HP) _____ (yield gpm)			
_____ (type power)			
(7) electric log <u>NO</u> (yes or no)			
_____ (organization running log)			
(8) how well bottom plugged <u>Steel Plate</u>			
<b>DRILLERS REMARKS:</b>			


CODED

DEPT. OF NATURAL RESOURCES  
BUREAU OF LAND & WATER RESOURCES

JUL 16 1981  
REC'D

If well telescopes please  
sketch and show depths.

GROUND LEVEL

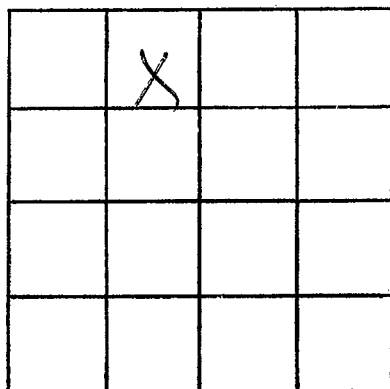

SECTION 23

Please indicate well location X.

ADDITIONAL INFORMATION

If more than one screen,  
show locations of each on sketch.