

MISSISSIPPI DEPARTMENT OF NATURAL RESOURCES

Bureau of Land and Water Resources

Southport Mall

P.O. Box 10631

Jackson, Mississippi 39209

CODED

WATER WELL DRILLERS LOG

Chasin John Patton DBA

Irrigation Equipment, Inc.

Sharkey

SHARKEY
B 37
6/14/83

6-14-83

date well completed

firm name

county well located

LANDOWNER: <u>Britch Patterson</u> <u>Box 248</u>	description of formations encountered	from	to
<u>Delta City, MS 39061</u> (mailing address)	Clay	0	35
	Fine Sand	36	60
	Coarse Sand	61	82
	Fine Sand	82	120
	Coarse Sand & gravel	120	136

LANDOWNER: Britch Patterson

Box 248

Delta City, MS 39061

(mailing address)

WELL LOCATION:

sec. 31 T. 14 N. R. 5 E. S. W

$\frac{1}{2}$ miles S of Ritchey
(distance) (direction) (nearest town)

WELL PURPOSE: irrigation
(home, irrigation, municipal, industrial)

WELL COMPLETION DATA:

- (1) diameter (inches) 16"
- (2) total depth (feet) 136'
- (3) static water level (feet) 10' below above top of ground.

(4) casing steel 0-60-80-120'
(material) (depth)

(size) if telescope see back.

(5) screen 32' 61' & 120'
(length) (depth to top)
16" steel

(size) (material)
60 3600

(6) pump diesel
(HP) (yield gpm)
(type power)

(7) electric log (yes or no)

(organization running log)

(8) how well bottom plugged
steel plate


DRILLERS REMARKS:

CODED

DEPT. OF NATURAL RESOURCES
BUREAU OF LAND & WATER RESOURCES
JUN 20 1983
RECEIVED

If well telescopes please
sketch and show depths.

GROUND LEVEL

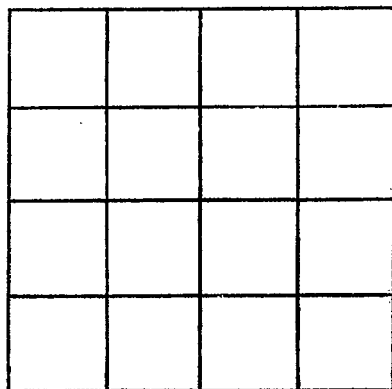

SECTION _____

Please indicate well location X.

ADDITIONAL INFORMATION

If more than one screen,
show locations of each on sketch.