

MISSISSIPPI DEPARTMENT OF NATURAL RESOURCES

Bureau of Land and Water Resources

Southport Mall

P.O. Box 10631

Jackson, Mississippi 39209

WATER WELL DRILLERS LOG

CODED

Sharkey  
B 39  
5/10/82

5/10 1982 Lamp well & pump Sharkey  
 date well completed firm name county well located

LANDOWNER: A.B. Williams

description of formations encountered from to

(mailing address)

WELL LOCATION:  
 sec. 18 T. 14 N R. 5 W  
2 miles SE of Delta city  
 (distance) (direction) (nearest town)

WELL PURPOSE:  
 (home, irrigation, municipal, industrial)

WELL COMPLETION DATA:

- (1) diameter (inches) 8"
- (2) total depth (feet) 100'
- (3) static water level (feet) 92 below above top of ground.
- (4) casing PVC, 60,  
 (material) (depth)  
 (size) if telescope see back.
- (5) screen 40, 60  
 (length) (depth to top)  
8", PVC  
 (size) (material)
- (6) pump 7 1/2, 500  
 (HP) (yield gpm)  
Elec.  
 (type power)
- (7) electric log no  
 (yes or no)

(organization running log)

(8) how well bottom plugged PVC  
cap

DRILLERS REMARKS:

0-18 clay  
18-35 fine sand  
35-60 med sand  
50-100 coarse sand

CODED


DEPT. OF NATURAL RESOURCES  
 BUREAU OF LAND & WATER RESOURCES

JUN 30 1982

RECEIVED

If well telescopes please sketch and show depths.

GROUND LEVEL

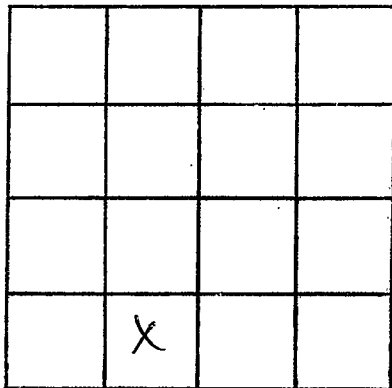

SECTION 18

Please indicate well location X.

ADDITIONAL INFORMATION

If more than one screen,  
show locations of each on sketch.