

MISSISSIPPI DEPARTMENT OF NATURAL RESOURCES

Bureau of Land and Water Resources

Southport Mall

P.O. Box 10631

Jackson, Mississippi 39209

**CODED**

**WATER WELL DRILLERS LOG**

Sharkey  
B 40  
5/6/82

5/06 19 82  
date well completed

Larry's well & pump Sharkey  
firm name county well located

LANDOWNER: Billy Chikscalas

description of formations encountered from to

Delta city, Miss  
(mailing address)

0-16 clay  
16-30 fine sand  
30-55 med sand  
55-106 coarse sand

WELL LOCATION:  
sec. 20 T. 14 N. R. 5 E.  
4 miles SE of Delta city  
(distance) (direction) (nearest town)

WELL PURPOSE:  
(home, irrigation, municipal, industrial)

**CODED**

WELL COMPLETION DATA:

- (1) diameter (inches) 16"
- (2) total depth (feet) 106'
- (3) static water level (feet) 23 below above top of ground.
- (4) casing STEEL, 66,  
(material) (depth)  
(size) if telescope see back.
- (5) screen 40, 66  
(length) (depth to top)  
(size) STEEL (material)
- (6) pump 80, 1200  
(HP) (yield gpm)  
DSL power unit  
(type power)
- (7) electric log No  
(yes or no)

(organization running log)


(8) how well bottom plugged Steel Plate

DRILLERS REMARKS:

DEPT. OF NATURAL RESOURCES  
BUREAU OF LAND & WATER RESOURCES  
JUN 30 1982  
**RECEIVED**

If well telescopes please sketch and show depths.

GROUND LEVEL

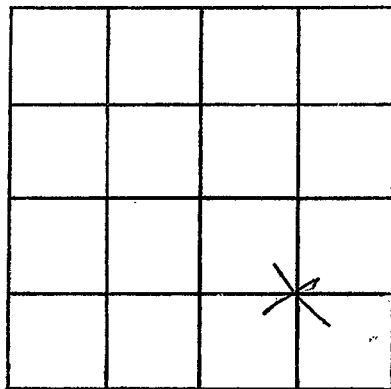

SECTION 20

Please indicate well location X.

ADDITIONAL INFORMATION

If more than one screen,  
show locations of each on sketch.