

MISSISSIPPI DEPARTMENT OF NATURAL RESOURCES

Bureau of Land and Water Resources

Southport Mall

P.O. Box 10631

Jackson, Mississippi 39209

WATER WELL DRILLERS LOG

CODED

Shuckey
B 41
5/6/82

05/06 1982 Harry's well pump Shuckey
date well completed firm name county well located

LANDOWNER: <u>Billy Clinkard</u>	description of formations encountered	from	to
<u>Delta City, Miss</u> (mailing address)	<u>0-15 clay</u> <u>15-30 fine sand</u> <u>30-50 med sand</u> <u>50-102 coarse sand</u>		
WELL LOCATION: sec <u>20</u> T <u>14</u> N R <u>5</u> E <u>4</u> miles <u>SE</u> of <u>Delta City</u> (distance) (direction) (nearest town)			
WELL PURPOSE: (home, irrigation, municipal, industrial)			
WELL COMPLETION DATA:			
(1) diameter (inches) <u>16"</u>			
(2) total depth (feet) <u>102'</u>			
(3) static water level (feet) <u>23</u> below above top of ground.			
(4) casing <u>STEEL</u> , <u>62</u> (material) (depth)			
(size) If telescope see back.			
(5) screen <u>STEEL</u> , <u>62</u> (length) (depth to top)			
<u>16</u> , <u>STEEL</u> (size) (material)			
(6) pump <u>80</u> <u>1200</u> (HP) (yield gpm)			
<u>DSH Paul unit</u> (type power)			
(7) electric log <u>NO</u> (yes or no)			
(organization running log)			
(8) how well bottom plugged <u>Steel Plate</u>			
DRILLERS REMARKS:			

CODED


DEPT. OF NATURAL RESOURCES
BUREAU OF LAND & WATER RESOURCES

JUN 30 1982

RECEIVED

If well telescopes please sketch and show depths.

GROUND LEVEL

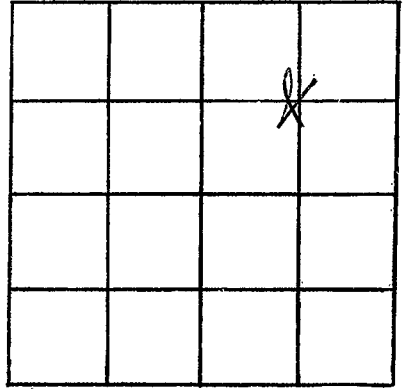

SECTION 20

Please indicate well location X.

ADDITIONAL INFORMATION

If more than one screen,
show locations of each on sketch.